46-1655 1286 FILED NO ...

BOOK 1 PAGE 427

RECORDED COMPARED 96 NOV -7 PM 2: 21


MICHELLE UTSLER RECORDER MADISON COUNTY IOWA

VANCE & HOCHSTETLER, P.C. CONSULTING ENGINEERS, WINTERSET, IOWA (515)462-3995

CHARLES T. VANCE, 110 West Green St., Winterset, Iowa 50. JAMES M. HOCHSTETLER, 110 West Green St., Winterset, Iowa 50273 50273

SLSI 9-94

UNITED STATES PUBLIC LAND SURVEY CORNER CERTIFICATE

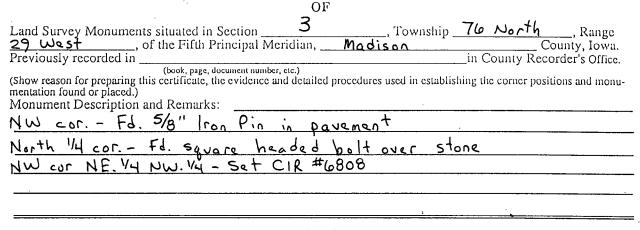

(Show a minimum of three reference ties to durable physical objects, relevant monuments and physical conditions that will enable recovery of the corner.)

NW corner

Sec. 3-76-29 Fd. 5/8" Iron Pin in slab "X" Nailsin Gate Post Grader Blade 94.56 96.09

> Grader Blade W/cut "X"

North 14 cor. Sec. 3-76-29 Fd. Square Headed Bolt over stone (13"deep) X" Nails in 33.SS "X" Nails in 32.20 Power Pole "X" Nailsin Fence Post

NW corner NE. 14 NW. 14 Sec. 3-76-29 Sa+ CIR #6808

X" Nails in COT. POS 34.14 31.44' "X" "Wails in

I hereby certify that the survey work was completed and this land surveying document was prepared by me or under my direct personal supervision and that I am a duly registered land surveyor under the laws of the state of Jowa

Signature:

Name typed or printed:

11/7/96 Reg. No

6808

My registration renewal date is December 31, 1997

PROFESSIONAL EGISTERES HOCHSTETLER 6808 NO SURVE

List Corners to be Indexed			
Corners	Section	Twp	Range
NW cor.	3	76N	WPS
4. 14 cor.	3	76 N	29 W
W cor.	3	76N	29 W

SEAL