UNITED STATES PUBLIC LAND SURVEY CORNER CERTIFICATE


OF

Land Survey Monuments situated in Section Twenty-six (26), Township 89 North, Range Six (6) West, of the Fifth Principal Meridian, Delaware County, Iowa.
Previously recorded in Book ---, Page ---.

(Show reason for preparing this certificate, the evidence and detailed procedures used in establishing the corner positions and monumentation found or placed.)
Monument Description and Remarks: No certificate on file at Recorder's Office. Set chiseled "X" in concrete pavement using old corner ties and 1970-71 County Road plans and easements. Set at 56.6 feet from hole in bedrock where power pole was and 455 feet from Station 0+00.

PLAN - VIEW

(Show a minimum of three reference ties to durable physical objects. relevant monuments and physical conditions that will enable recovery of the corner.)

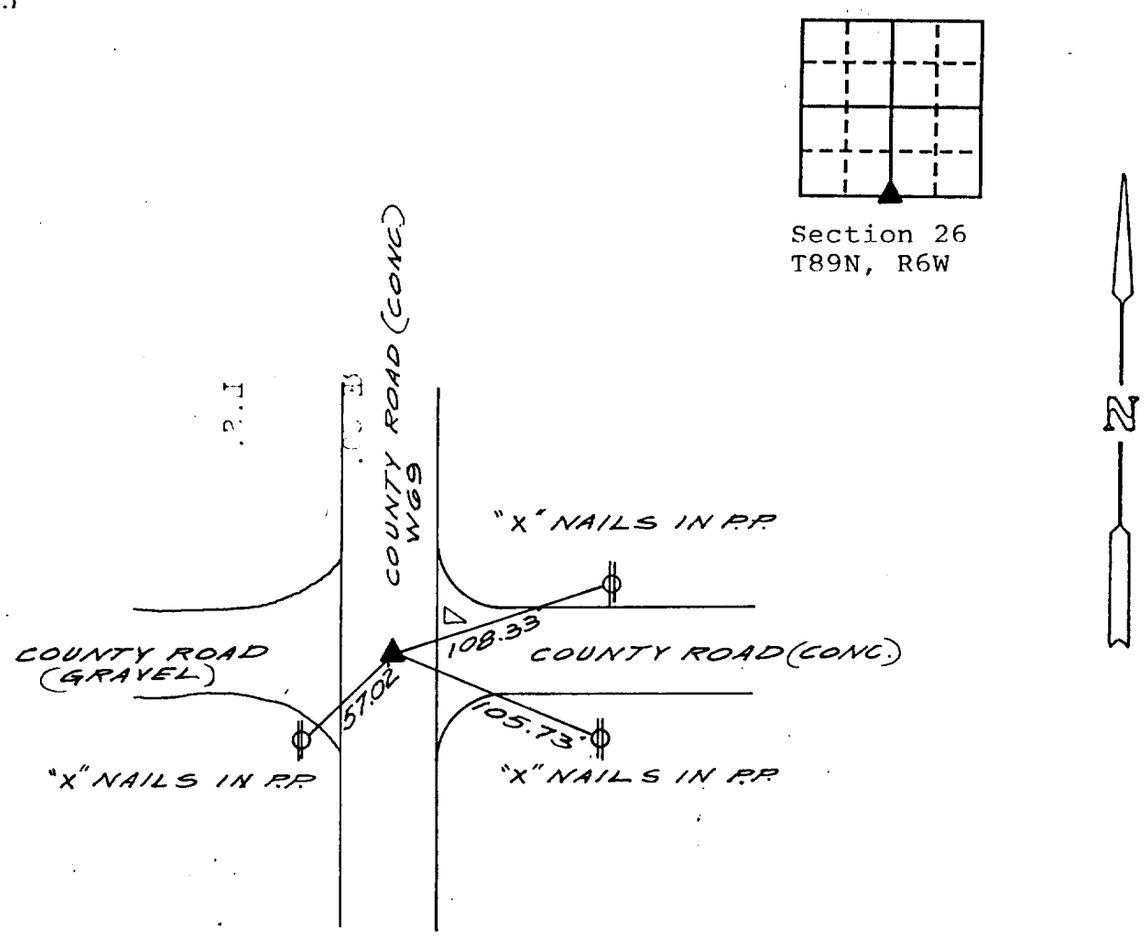

DATE OF FIELD WORK: 11/27/90

TSE NO. 90-62

I hereby certify that the survey work was completed and this certificate was prepared by me or under my direct personal supervision and that I am a duly registered land surveyor under the laws of the state of Iowa.

Roger R. Mohn 11/27/90
DATE

REGISTERED LAND SURVEYOR NO. 10165

SEAL

LAND SURVEYOR
REGISTERED
ROGER R. MOHN
10165
IOWA

List Corners to be Indexed

Corners	Section	Twp	Range
S 1/4	26	89N	6W
N 1/4	35	89N	6W

FILE No. 59-1319
RECORDING FEE $ 5.00
TRANSFER FEE $

FILED FOR RECORD THE 5 DAY OF December, 19 90 AT 4:18 O'CLOCK P. M. BOOK 1 PAGE 26

STATE OF IOWA, DELAWARE COUNTY
Joan Sheppard, Recorder
Cor, Mon.