SLSI 9-90

UNITED STATES PUBLIC LAND SURVEY CORNER CERTIFICATE

OF

Land Survey Monuments situated in Section 34, Township 88 North, Range 6 West, of the Fifth Principal Meridian, Delaware County, Iowa.
Previously recorded in no current references on file in County Recorder's Office.
(book, page, document number, etc.)

(Show reason for preparing this certificate, the evidence and detailed procedures used in establishing the corner positions and monumentation found or placed.)

Monument Description and Remarks:

NW Corner - No visual evidence of reference ties; found 1/2" smooth bar 4" deep; Retied.


W 1/4 Corner - Found reference tie nails in wood posts & power pole; found 1/2" spiral rebar 3" deep; Retied.

S 1/4 Corner - Found reference nails in wood post; found 80 D spike 3" deep; Retied.

E 1/4 Corner - Found bottle caps and nail in power pole and posts; found 1/2" rebar 4" deep; Retied.

PLAN - VIEW

(Show a minimum of three reference ties to durable physical objects, relevant monuments and physical conditions that will enable recovery of the corner.)

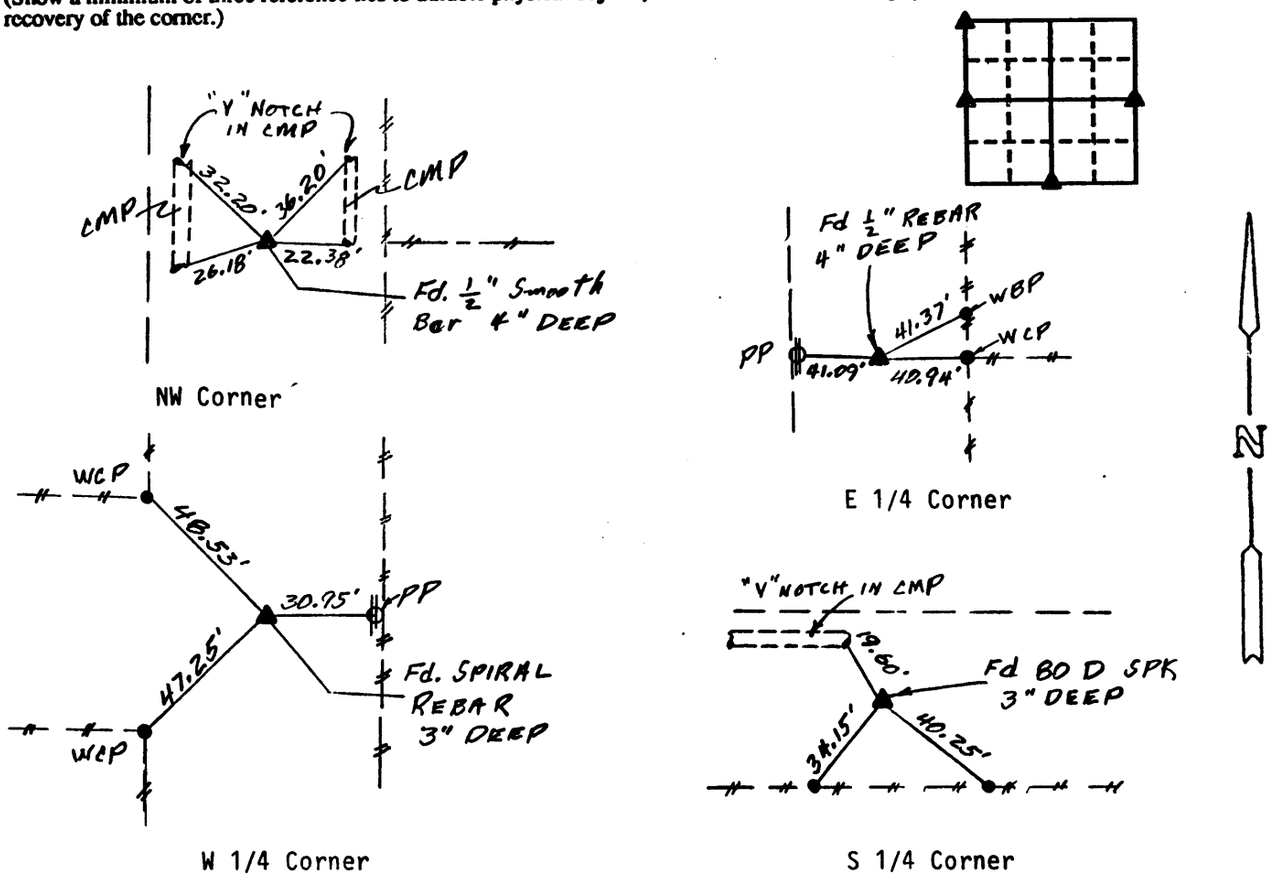

I hereby certify that the survey work was completed and this certificate was prepared by me or under my direct personal supervision and that I am a duly registered land surveyor under the laws of the state of Iowa.

Signature: John R. Crawford
Name typed or printed: John R. Crawford, R.L.S.
Date: 1/5/94 Reg. No. 7474

List Corners to be Indexed

Corners	Section	Twp	Range
NW Corner	34	88	6
W 1/4 Corner	34	88	6
S 1/4 Corner	34	88	6
E 1/4 Corner	34	88	6

SEAL

REGISTERED PROFESSIONAL ENGINEER John R. Crawford 7474 IOWA

REGISTERED LAND SURVEYOR JOHN R. CRAWFORD 7474 IOWA

FILE No. 1-2127
RECORDING FEE $ 6.00
TRANSFER FEE $

FILED FOR RECORD THE 10 DAY OF January, 19 94 AT 11:00 O'CLOCK A M. BOOK 1 PAGE 248

STATE OF IOWA, DELAWARE COUNTY
Deborah L. Peyton, Recorder
Cor. Mon.