SLSI 9-90

UNITED STATES PUBLIC LAND SURVEY CORNER CERTIFICATE

OF

Land Survey Monuments situated in Section 18, Township 87 North, Range 3 West, of the Fifth Principal Meridian, Delaware County, Iowa.
Previously recorded in no corner certificate on file in County Recorder's Office.
(book, page, document number, etc.)


(Show reason for preparing this certificate, the evidence and detailed procedures used in establishing the corner positions and monumentation found or placed.)

Monument Description and Remarks: Found iron pin next to leaning limestone at the South ¼ Corner. Accepted iron pin as the corner. Found iron rod w/o cap at the NW Corner of the SW¼-NE¼.


PLAN - VIEW

(Show a minimum of three reference ties to durable physical objects, relevant monuments and physical conditions that will enable recovery of the corner.)


South ¼ Corner of Section 18

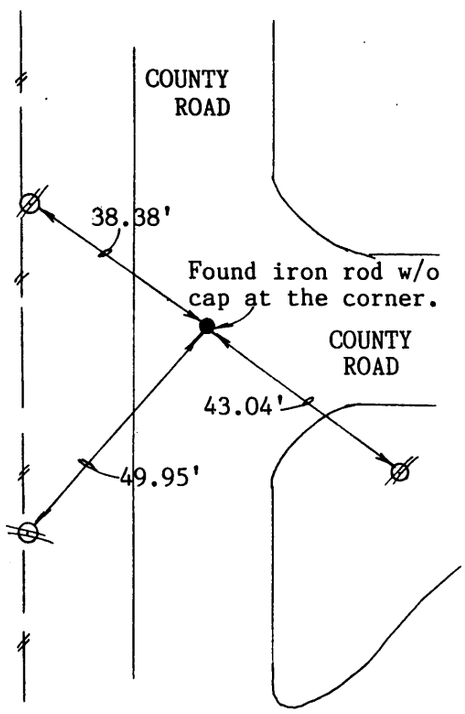

"x" nails in power poles at all accessory points.

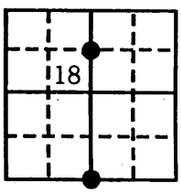

NW Corner of the SW¼-NE¼ of Section 18

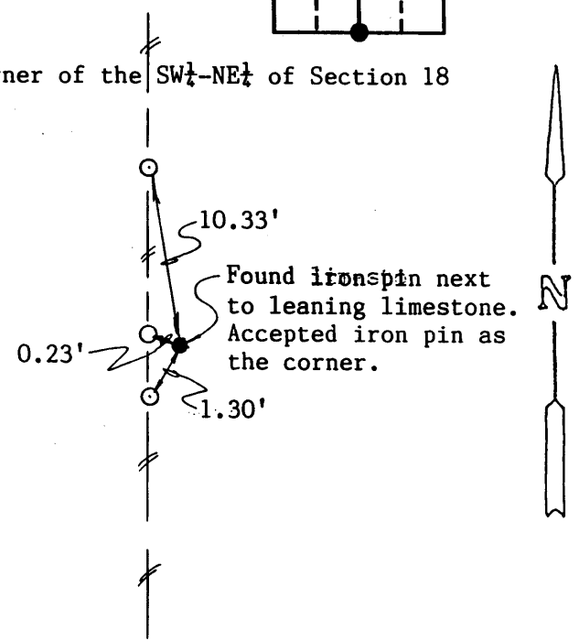


"x" nails in wood post at all accessory points.

I hereby certify that the survey work was completed and this certificate was prepared by me or under my direct personal supervision and that I am a duly registered land surveyor under the laws of the state of Iowa.

Signature: Roger R. Mohn
Name typed or printed: Roger R. Mohn
Date: March 11, 1994 Reg. No. 10165

SEAL

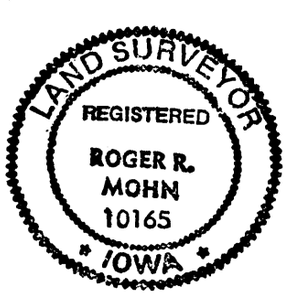

List Corners to be Indexed

Corners	Section	Twp	Range
South ¼ Cor.	18	87N	3W
NW Cor. of SW¼-NE¼	18	87N	3W

Correction Affidavit For Distance, See Book 217 Page 226 6-21-94

FILE No. 21-2879
RECORDING FEE $ 6.00
TRANSFER FEE $

FILED FOR RECORD THE 24 DAY OF Mar, 1994 AT 11:31 O'CLOCK A. M. BOOK 1 PAGE 259

STATE OF IOWA, DELAWARE COUNTY
Deborah L. Peyton, Recorder
Cor. Mon.