
PLAT OF SURVEY

PARCEL I PART OF ZAMBOANGA AVENUE, CLAIR VIEW ACRES, SECTION TWENTY-THREE (23) AND SECTION TWENTY-SIX (26), TOWNSHIP EIGHTY-EIGHT NORTH (T88N), RANGE FIVE WEST (R5W) OF THE FIFTH PRINCIPAL MERIDIAN, DELAWARE COUNTY, IOWA

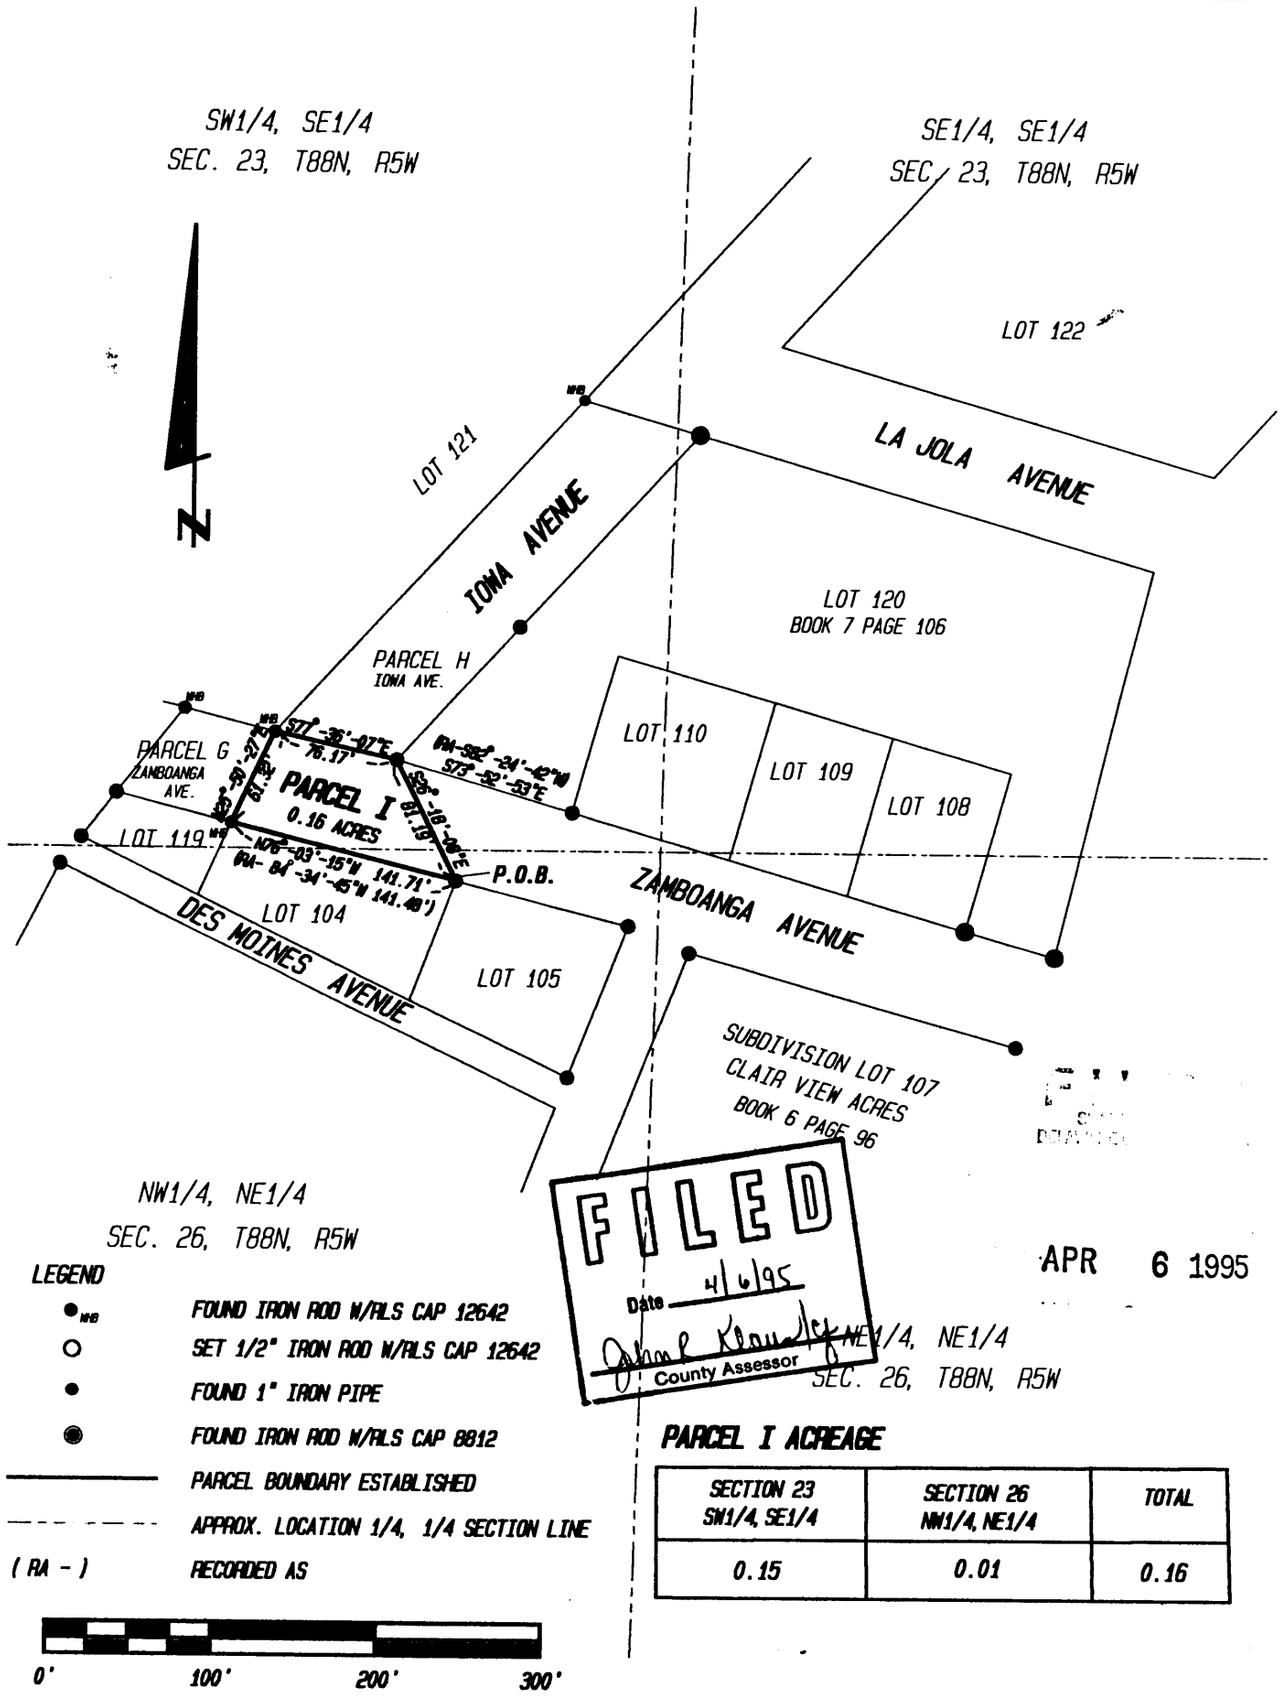

FILED
Date 4/6/95
County Assessor
APR 6 1995

LEGEND

- ● FOUND IRON ROD W/RLS CAP 12642
- ○ SET 1/2" IRON ROD W/RLS CAP 12642
- ● FOUND 1" IRON PIPE
- ◉ FOUND IRON ROD W/RLS CAP 8812
- ——— PARCEL BOUNDARY ESTABLISHED
- - - - - - APPROX. LOCATION 1/4, 1/4 SECTION LINE
- (RA -) RECORDED AS

0' 100' 200' 300'

PARCEL I ACREAGE

SECTION 23 SW1/4, SE1/4	SECTION 26 NW1/4, NE1/4	TOTAL
0.15	0.01	0.16

SCALE: 1" = 100'

DATE OF SURVEY: 3/6/95, 3/21/95

SHEET 1 OF 3

PROPRIETORS: FRED R. THOMAS & DOROTHY THOMAS (DEDICATED TO PUBLIC USE)

REGISTERED LAND SURVEYOR
WILLIAM H. BURGER
12642
IOWA

Wm. Burger
LandSurveyors
510 3rd Street West Court
Worthington, Iowa 52078

I HEREBY CERTIFY THAT THIS SURVEY AND PLAT WAS MADE BY ME OR UNDER MY DIRECT PERSONAL SUPERVISION AND THAT I AM A DULY REGISTERED LANDSURVEYOR UNDER THE LAWS OF THE STATE OF IOWA. MY REGISTRATION EXPIRES 12/31/96

William H. Burger 4/5/95
WILLIAM H. BURGER #12642 DATE

FILE No. 117-2580
RECORDING FEE $ 16.00
TRANSFER FEE $

FILED FOR RECORD THE 6 DAY OF April, 1995 AT 4:09 O'CLOCK P M. BOOK 7 PAGE 126

STATE OF IOWA, DELAWARE COUNTY
Deborah L. Peyton, Recorder
Plat

LEGAL DESCRIPTION:

PARCEL I - Part of Zamboanga Avenue , Clair View Acres , Section Twenty-three (23), and Section Twenty-six (26), Township Eighty-eight North (T88N), Range Five West (R5W) of the Fifth Principal Meridian , Delaware County , Iowa as recorded in the Office of the Delaware County Recorder , Plat Book 2 , Page 200 ; containing a total of 0.16 acres , subject to easements of record and more particularly described by metes and bounds as follows:

Beginning at the Northeasterly corner of Lot One Hundred Four (104) , Clair View Acres , Section Twenty-three (23) and Section Twenty-six (26) , Township Eighty-eight North (T88N), Range Five West (R5W) of the Fifth Principal Meridian , Delaware County , Iowa ; thence North 76°-03'-15" West 141.71 feet along the Northerly line and to the Northwesterly corner of said Lot One Hundred Four (104) ; thence North 25°-50'-27" East 61.32 feet to the Southeasterly corner of Lot One Hundred Twenty-one (121) of said Clair View Acres ; thence South 77°-36'-07" East 76.17 feet to the Southwesterly corner of Lot One Hundred Twenty (120) of said Clair View Acres; thence South 26°-18'-08" East 81.19 feet to the POINT OF BEGINNING ; containing a total of 0.16 acres , subject to easements of record .
The South line of the Southeast Quarter of Section Twenty-three (23) Township Eighty-eight North (T88N), Range Five West (R5W) of the Fifth Principal Meridian , Delaware County , Iowa is assumed to bear North 90°-00'-00" East.

SURVEYORS CERTIFICATE :

I hereby certify that this survey and plat was made by me or under my direct personal supervision , and that I am a duly Registered Land Surveyor under the laws of the State of Iowa.

William H. Burger 4/5/95

William H. Burger Date Reg. No. 12642



OWNERS ACKNOWLEDGMENT

I (We) Fred R. Thomas & Dorothy Thomas of Delaware County, State of Iowa, do hereby certify that the above survey, as shown by the attached Plat, is made with my (our) free consent, and in accordance with my (our) desire.

Fred R. Thomas 4-2-95

Dorothy Thomas

Dorothy Thomas

STATE OF IOWA
COUNTY OF Delaware

On this 2nd day of April A. D. 1995 before me, a Notary Public in and for said County, personally appeared Fred R. Thomas & Dorothy Thomas, to me known to be the ~~person~~ ~~or~~ persons named in and who executed the foregoing instrument, and acknowledged that They executed the same as Their voluntary act and deed.

Marcheta R. Cooey
Notary Public in and for said County
MARCHETA R. COOEY

