DELAWARE COUNTY IOWA
FILED
96 MAR 1 AM 11 10
197-2347
DEBORAH L. PEYTON
DELAWARE CO. RECORDER
$16.00
BOOK 7 PAGE 176


Roger R. Mohn R.L.S.
To
Puffett Farms, Inc.
Etal

Mohn Surveying
1888 Great River
Lansing, IA 52151

MOHN SURVEYING ROGER R. MOHN 1888 GREAT RIVER ROAD LANSING, IOWA 52151 (319) 538-4067

PLAT OF SURVEY

PARCEL "A" CONSISTING OF PART OF THE SOUTHWEST QUARTER OF THE NORTHWEST QUARTER (SW¼-NW¼), PART OF THE SOUTHEAST QUARTER OF THE NORTHWEST QUARTER (SE¼-NW¼) AND PART OF THE SOUTHWEST QUARTER OF THE NORTHEAST QUARTER (SW¼-NE¼); ALL IN SECTION 14, TOWNSHIP 90 NORTH, RANGE 6 WEST OF THE FIFTH PRINCIPAL MERIDIAN DELAWARE COUNTY, IOWA.

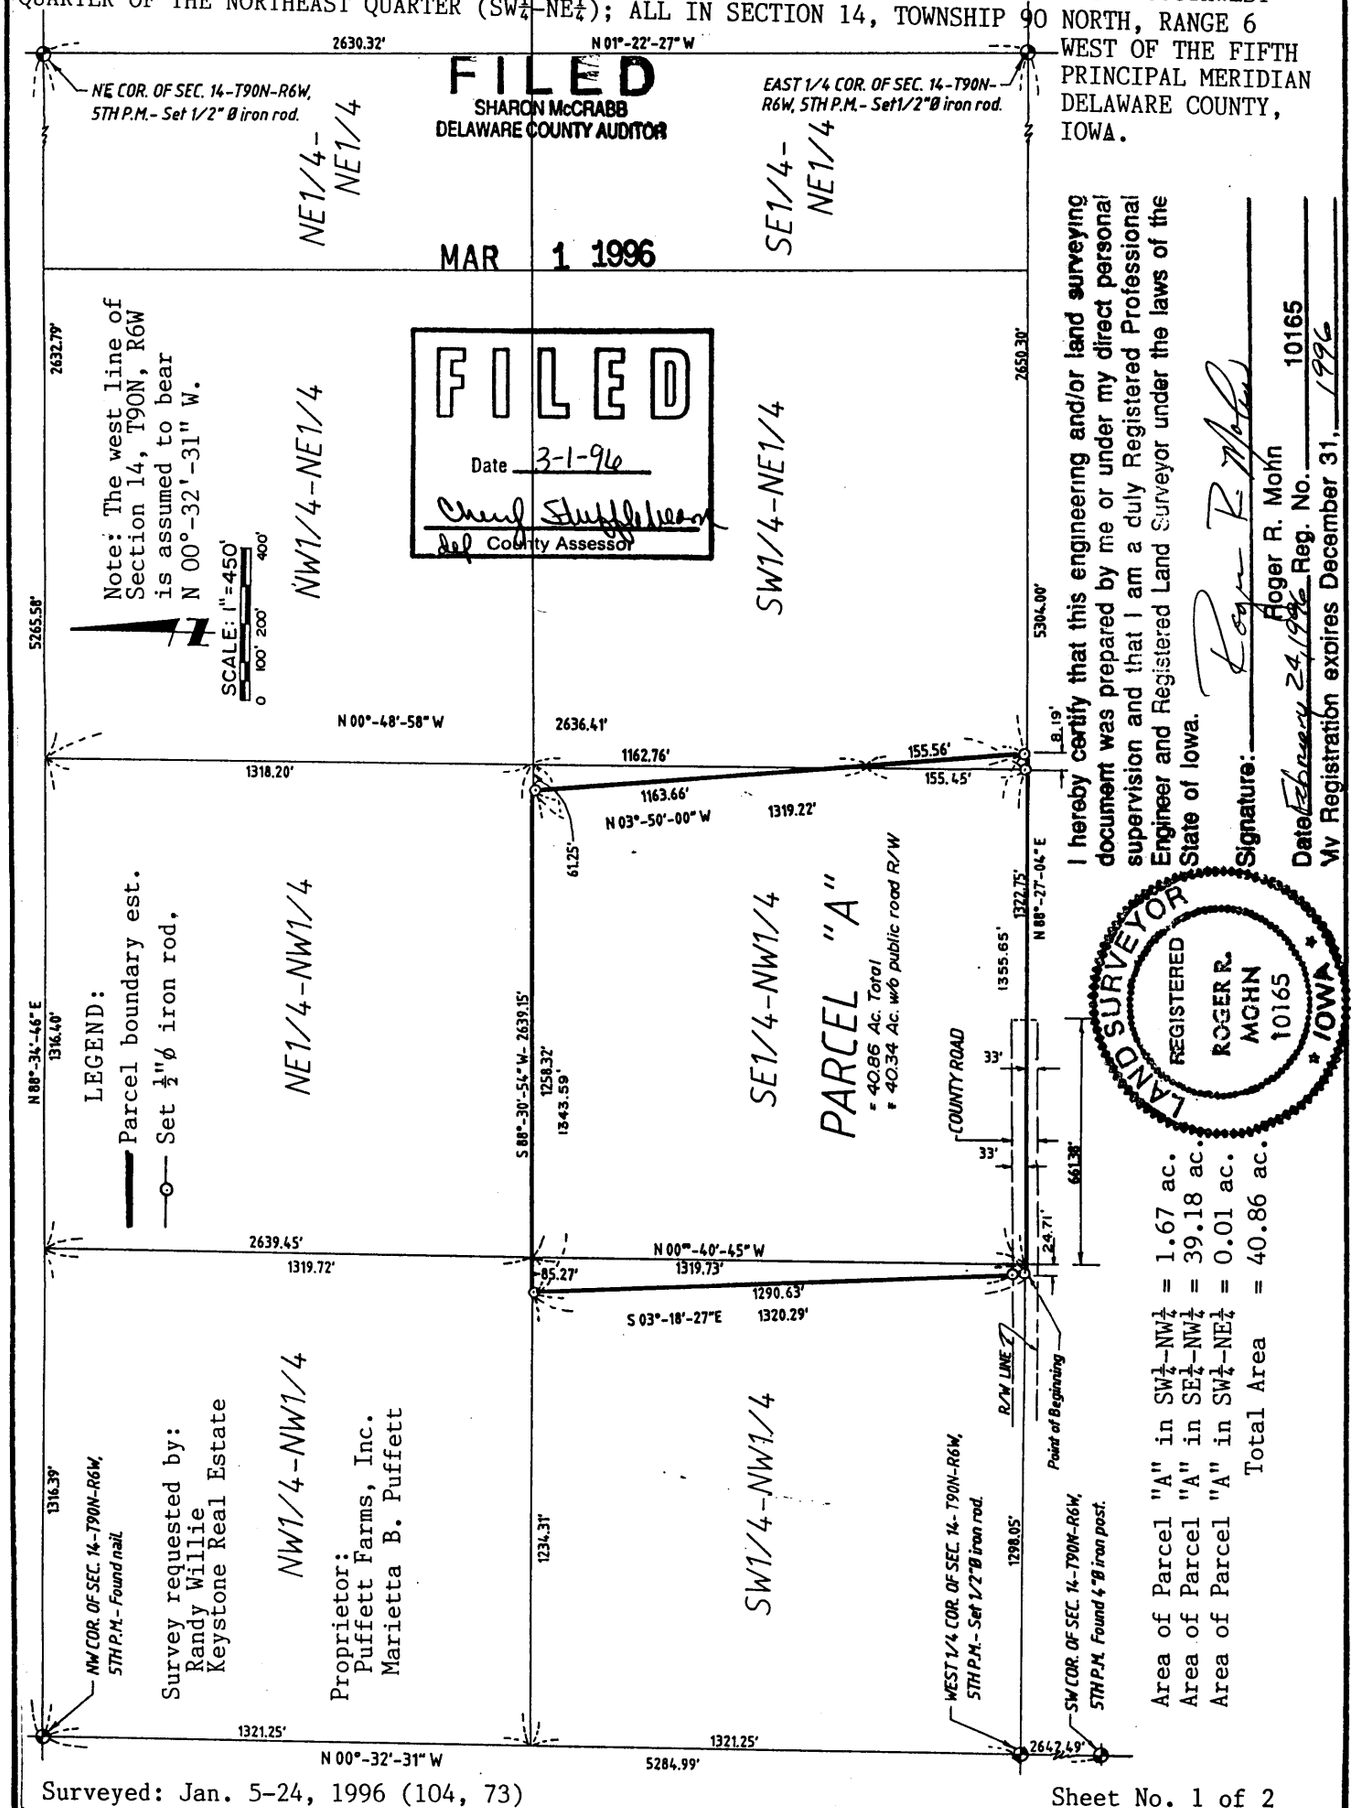

I hereby certify that this engineering and/or land surveying document was prepared by me or under my direct personal supervision and that I am a duly Registered Professional Engineer and Registered Land Surveyor under the laws of the State of Iowa.

Signature: Roger R. Mohn
Roger R. Mohn 10165
Date February 24, 1996 Reg. No.
My Registration expires December 31, 1996

REGISTERED LAND SURVEYOR ROGER R. MOHN 10165 IOWA

Area of Parcel "A" in SW¼-NW¼ = 1.67 ac.
Area of Parcel "A" in SE¼-NW¼ = 39.18 ac.
Area of Parcel "A" in SW¼-NE¼ = 0.01 ac.
Total Area = 40.86 ac.

Surveyed: Jan. 5-24, 1996 (104, 73)

Sheet No. 1 of 2

FILE No. 197-2347
RECORDING FEE $ 16.00
TRANSFER FEE $

FILED FOR RECORD THE 1 DAY OF March, 1996 AT 11:10 O'CLOCK A M. BOOK 7 PAGE 176


STATE OF IOWA, DELAWARE COUNTY
Deborah L. Peyton, Recorder
Plat

MOHN SURVEYING 1888 GREAT RIVER ROAD LANSING, IOWA 52151 (319) 538-4067

PLAT OF SURVEY
OF

Parcel "A" consisting of part of the Southwest Quarter of the Northwest Quarter (SW1/4-NW1/4), part of the Southeast Quarter of the Northwest Quarter (SE1/4-NW1/4) and part of the Southwest Quarter of the Northeast Quarter (SW1/4-NE1/4); all in Section Fourteen (14), Township Ninety (90) North, Range Six (6) West of the Fifth Principal Meridian, Delaware County, Iowa, containing a total of 40.86 acres, more or less, and more particularly described by metes and bounds as follows:

Commencing at the West 1/4 Corner of Section 14, Township 90 North, Range 6 West of the 5th P.M.; thence N 88°-27'-04" E, 1298.05 feet along the east-west 1/4 section line of said Section 14 to the Point of Beginning; thence N 88°-27'-04" E, 1355.65 feet along said 1/4 section line; thence N 03°-50'-00" W, 1319.22 feet; thence S 88°-30'-54" W, 1343.59 feet along the north line of the South One-half of the Northwest Quarter of said Section 14; thence S 03°-18'-27" E, 1320.29 feet to the Point of Beginning. Said described parcel contains 40.86 acres, more or less. The west line of Section 14, T90N, R6W is assumed to bear N 00°-32'-31" W.

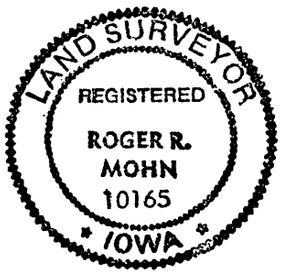

I hereby certify that this plat, map, survey or report was made by me or under my direct personal supervision, and that I am a duly Registered Land Surveyor under the laws of the state of Iowa.

Roger R. Mohn

Roger R. Mohn

February 27, 1996 Reg. No. 10165

Date

My Registration expires December 31, 1996.

The attached plat represents a survey of Parcel "A" consisting of part of the Southwest Quarter of the Northwest Quarter (SW¼-NW¼), part of the Southeast Quarter of the Northwest Quarter (SE¼-NW¼) and part of the Southwest Quarter of the Northeast Quarter (SW¼-NE¼); all in Section 14, Township 90 North, Range 6 West of the Fifth Principal Meridian, Delaware County, Iowa.

I, Glenn L. Puffett of Delaware County, State of Iowa, being a duly sworn representative of Puffett Farms, Inc. President, do hereby certify that the above survey, as shown by the attached Plat, is made with my free consent and in accordance with the desire of the Board of Directors of said Corporation.


Glenn L. Puffett, Pres.

Glenn L. Puffett, Pres.

STATE OF IOWA, Delaware County, ss.

On the 27 day of February A.D. 1996 before me, a Notary Public in and for said County, personally appeared Glenn L. Puffett to me personally known, who being by me duly affirmed did say that person is President of said Puffett Farms, Inc., ~~that the seal affixed to said instrument is the seal of said Corporation~~ and that said instrument was signed ~~and sealed~~ on behalf of said Corporation by authority of its Board of Directors and the said _____ acknowledged the execution of said instrument to be the voluntary act and deed of said Corporation by it voluntarily executed.

Witness my hand and seal.

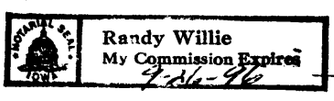

Randy Willie

Notary Public in and for said County

I (We) Marietta B. Puffett of Delaware County, State of Iowa, do hereby certify that the above survey, as shown by the attached Plat, is made with my (our) free consent and in accordance with my (our) desire.

X Marietta B. Puffett
Marietta B. Puffett

STATE OF IOWA, Delaware County, ss.

On the 27 day of February A.D. 1996 before me, a Notary Public in and for said County, personally appeared Marietta B. Puffett of said County, to me personally known to be the identical person(s) whose name(s) is (are) affixed to the foregoing statement, and acknowledged the same to be her voluntary act and deed.

Witness my hand and seal.

NOTARIAL SEAL IOWA
Randy Willie
My Commission Expires
9-26-96

Randy Willie
Notary Public in and for said County

NOTE: This plat of survey is the same as a plat of survey that is filed in Plat Book 7, page 168, Document No. 190-2068 of Delaware County Records. This plat of survey contains an additional acknowledgement of Marietta B. Puffett as consenting to this plat of survey.