Book 2005 Page 4472
Document 2005 4472 Type 06 007 Pages 1
Date 12/22/2005 Time 9:50 AM
Rec Amt $7.00

DEBORAH L. PEYTON, RECORDER/REGISTRA
DELAWARE COUNTY IOWA

Prepared by Wm. Burger LandSurveyors 510 3rd Street West Court, Worthington, Iowa Phone 563 - 855 2028

UNITED STATES PUBLIC LAND SURVEY CORNER CERTIFICATE

Land Survey Monuments situated in Section 15, Township 89N, Range 3W, of the Fifth Principal Meridian, Delaware County, Iowa. Previously recorded in N/A In the Office of the County Recorder

Monument Description and Remarks: (No Corner Certificates found at the County Recorders Office)


SE CORNER - SET 1/2" IRON ROD W/ YELLOW LS CAP #12642 - LOOKED AT MONUMENTS 1/2 MILE & 3/4 MILES TO THE EAST AND FENCELINE EVIDENCE TO THE SOUTH & NORTH AND TALKED TO PROPERTY OWNERS AND DECIDED SET THIS CORNER AT THE EXISTING CORNER POST.

SW CORNER - SET 1/2" IRON ROD W/ YELLOW LS CAP #12642 - USED FENCELINE EVIDENCE TO THE EAST AND SET IN THE CENTERLINE OF 310TH AVENUE

S1/4 CORNER - SET 1/2" IRON ROD W/ YELLOW LS CAP #12642 - SET ON LINE AND AT A PROPORTIONATE DISTANCE BETWEEN THE SW CORNER AND THE SE CORNER


PLAN VIEW

SE CORNER

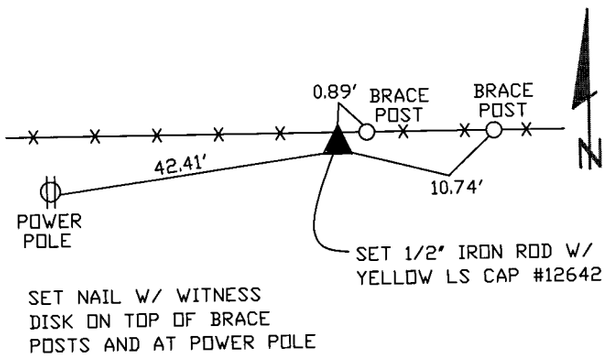


SET NAIL W/ WITNESS DISK ON TOP OF BRACE POSTS AND AT POWER POLE


SW CORNER

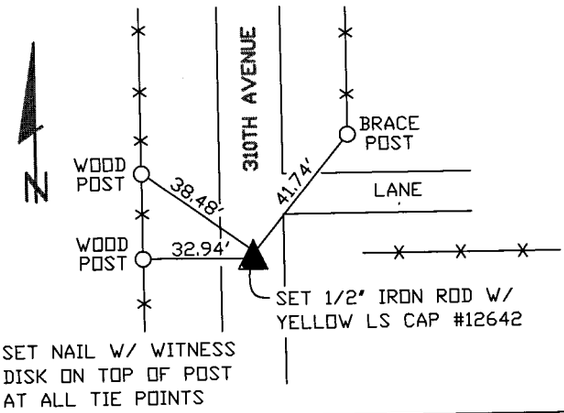

SET NAIL W/ WITNESS DISK ON TOP OF POST AT ALL TIE POINTS

S1/4 CORNER

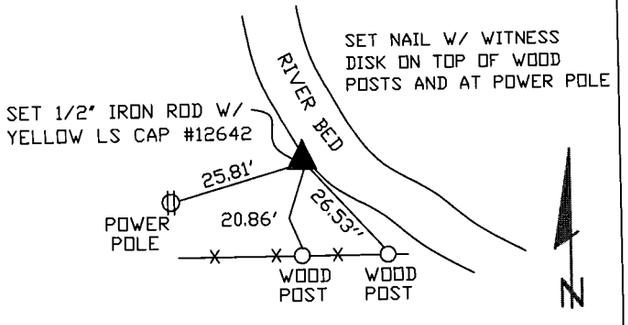

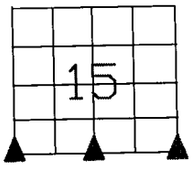

SEC. 15 TWP. 89N RANGE 3W

CORNERS TO BE INDEXED

SE CORNER	15	89N	3W
SW CORNER	15	89N	3W
S1/4 CORNER	15	89N	3W

LICENSED LAND SURVEYOR
WILLIAM H. BURGER
12642
IOWA

I hereby certify that this land surveying document was prepared and related survey work was performed by me or under my direct personal supervision and that I am a duly licensed Land Surveyor under the laws of the State of Iowa.

William H. Burger 12/21/05
William H. Burger Date
License number 12642
My license renewal date is December 31, 2006
Pages or Sheets covered by this seal: Sheet 1 of 1