Book 2006 Page 1829

Document 2006 1829 Type 06 007 Pages 1
Date 5/18/2006 Time 2:35 PM
Rec Amt $7.00

DEBORAH L. PEYTON, RECORDER/REGISTRA
DELAWARE COUNTY IOWA

TeKIPPE ENGINEERING, P.C., 1919-210th Street PO Box 357, Manchester, Iowa 52057 Phone (563) 927-2060

UNITED STATES PUBLIC LAND SURVEY CORNER CERTIFICATE

OF

Land Survey Monuments situated in Section 5, Township 90 North, Range 5 West of the Fifth Principal Meridian, Delaware County, Iowa.

Previously recorded in none in County Recorder's Office.
(book, page, document number, etc.)

(Show reason for preparing this certificate, the evidence and detailed procedures used in establishing the corner positions and monumentation found or placed.)


Monument Description and Remarks: **NW Corner Section 5, T90N, R5W** Found Hinge Nail

N 1/4 Corner Section 5, T90N, R5W Found Hinge Nail

Monuments found from information found on Iowa Department of Transportation As-Built Plans Numbered FN-579

PLAN - VIEW

(Show a minimum of three reference ties to durable physical objects, relevant monuments and physical conditions that will enable recovery of the corner.)

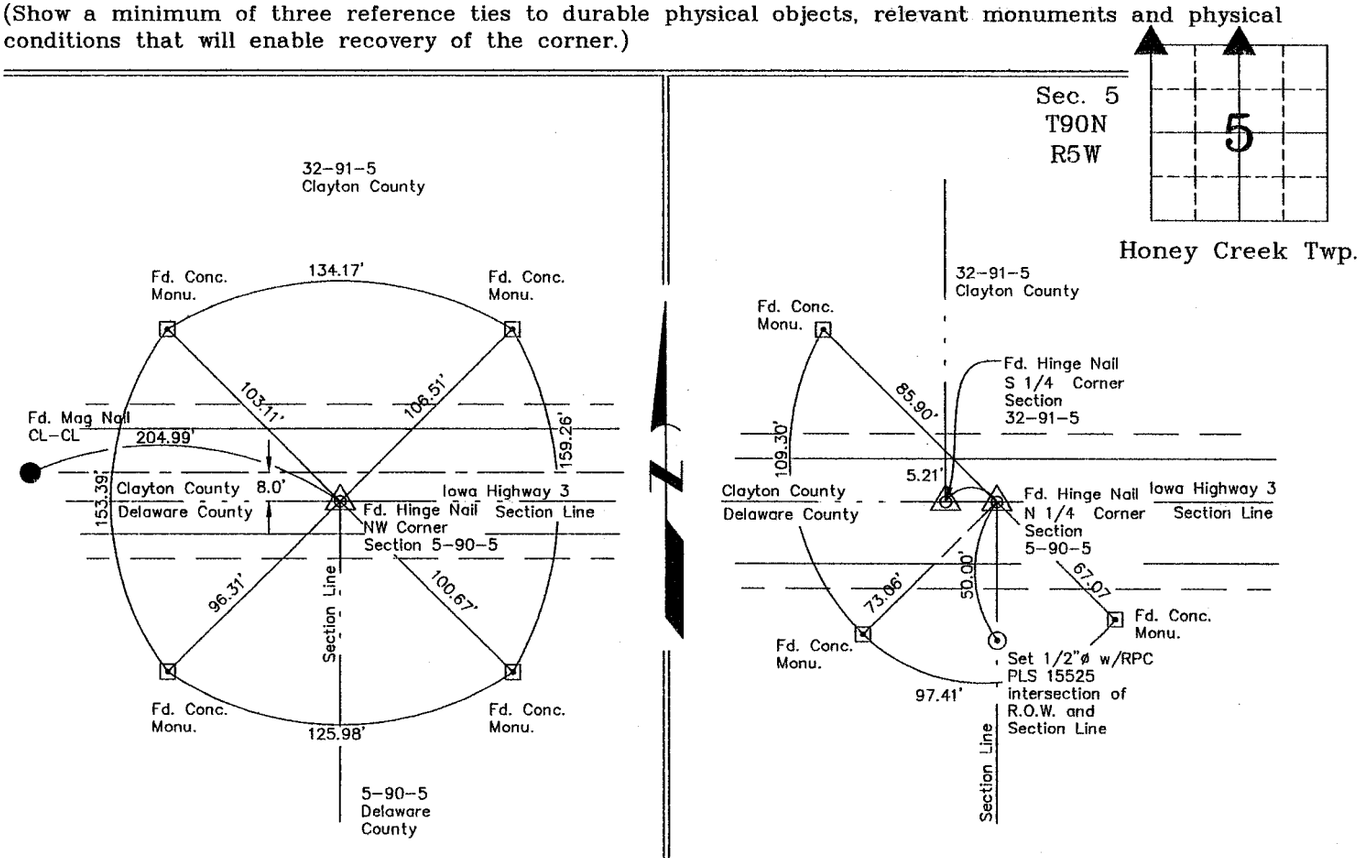

NW Corner Section 5, T90N, R5W
Fd. Hinge Nail

N 1/4 Corner Section 5, T90N, R5W
Found Hinge Nail

PROFESSIONAL LAND SURVEYOR
PAUL R. HEROLD
15525
IOWA

I hereby certify that this land surveying document was prepared and the related survey work was performed by me or under my direct personal supervision and that I am a duly licensed Land Surveyor under the laws of the State of Iowa.

Paul R. Herold 5-17-06

Paul R. Herold Date

License number 15525
My license renewal date is December 31, 2006.
Sheets covered by this seal: Individual

List Corners to be Indexed

Corners	Section	Twp.	Range
NW Corner	5	90	5
N 1/4	5	90	5

Project Number 06614.LS
FB. Edgewood No. 1 PG. 24