Book 2011 Page 1252

Document 2011 1252 Type 06 007 Pages 1
Date 4/14/2011 Time 12:01:34PM
Rec Amt $9.00

DEBORAH L PEYTON, RECORDER/REGISTRAR
DELAWARE COUNTY IOWA

*PREPARED BY: RANDALL L. RATTENBORG 105 WEST MAIN STREET MANCHESTER, IA 52057, 563-927-2434*


# *UNITED STATES PUBLIC LAND SURVEY CORNER CERTIFICATE OF*

Land Survey Monuments situated in Section 8, Township 88 North, Range 5 West of the Fifth Principal Meridian, Delaware County, Iowa. Previously recorded in County Recorder's Office in BK. 1, PG. 227 & BK. 2, PG. 76
(book, page, document number, etc.)

NW Corner – Found 5/8" Iron rod – no cap. Reference tie to power pole in both previously recorded ties no longer exists. This corner certificate is being prepared to reflect change in tie object.

## PLAN VIEW

(Show a minimum of three reference ties to durable physical objects, relevant monuments and physical conditions that will enable recovery of the corner.)

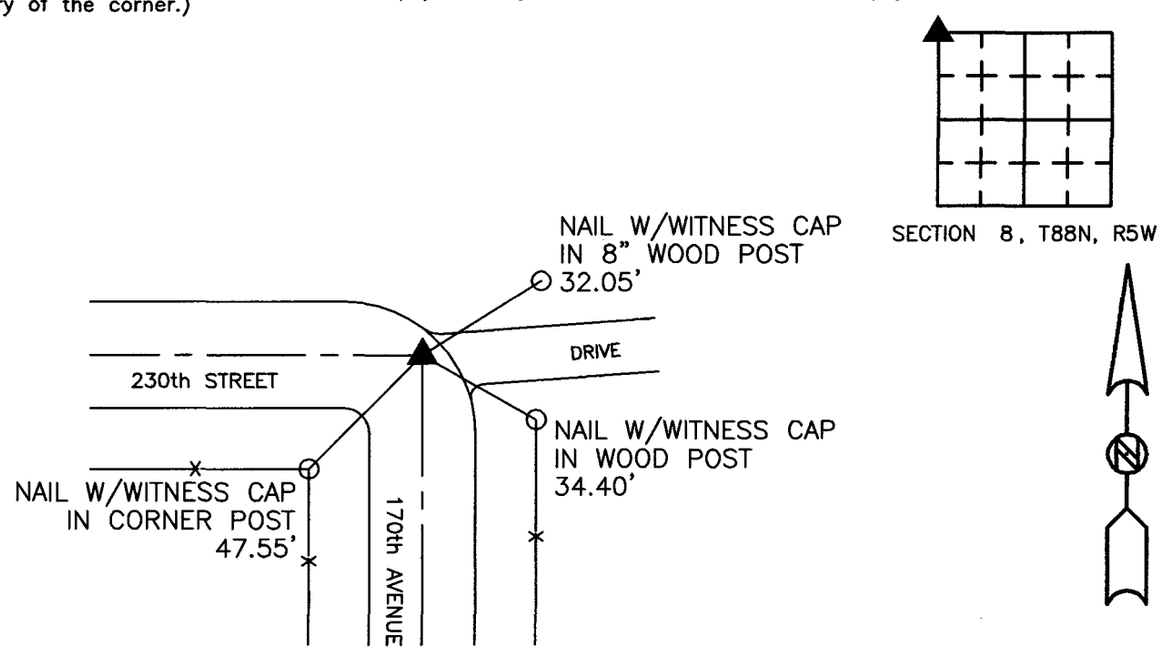


*NW CORNER*
*FOUND 5/8" IRON ROD – NO CAP*

TIES ARE TO PLAT OF PARCEL 1
IN SECTION 8, T88N, R5W

GIBBS ENGINEERING & SURVEYING PROJECT NO. 11-28

I hereby certify that this land surveying document was prepared and the related survey work was performed by me or under my direct personal supervision and that I am a duly licensed land surveyor under the laws of the State of Iowa.

Signature _____
Randall L. Rattenborg

Date 4/13/2011 Lic. No. 17939

My license renewal date is December 31, 2011

List Corners to be Indexed:

| Corners | Section | Township | Range |
|---|---|---|---|
| NW Corner | 8 | T88N | R5W |

Seal

LICENSED LAND SURVEYOR
RANDALL L. RATTENBORG
17939
IOWA

Seal covers this sheet only