Book 2013 Page 2182

Document 2013 2182 Type 06 007 Pages 1
Date 6/28/2013 Time 9:58:38AM
Rec Amt $7.00

DEBORAH L PEYTON, RECORDER/REGISTRAR
DELAWARE COUNTY IOWA

PREPARED BY & RETURN TO ERIC MILLER, SNYDER & ASSOCIATES, INC. 2727 SW SNYDER ROAD, ANKENY, IOWA 50023 (515) 964-2020

UNITED STATES PUBLIC LAND SURVEY CORNER CERTIFICATE OF

Land Survey Monuments situated in Section 18, Township 90 N, Range 04 W, of the Fifth Principal Meridian, DELAWARE, County, Iowa.
Previously recorded in N/A in County Recorder's Office.
(book, page, document number, ect.)

(Show reason for preparing this certificate, the evidence and detailed procedures used in establishing the corner positions and monumentation found or placed.)


Monument Description and Remarks:

NORTHWEST CORNER 18-90-04


NO PREVIOUS RECORD OF MONUMENTATION WAS FOUND. USED METAL DETECTOR AND VISUAL SEARCH OF THE AREA TO FIND 5/8" REBAR WITH ILLEGIBLE YELLOW PLASTIC CAP 1" DEEP. VERIFIED LOCATION OF MONUMENT WITH SURROUNDING FIELD EVIDENCE AND ACCEPTED MONUMENT AS SECTION CORNER. THIS CERTIFICATE IS BEING FILED BECAUSE THERE IS NO CERTIFICATE FOR THE CORNER ON FILE.

Plan-View

(Show a minimum of three reference ties to durable physical objects, relevant monuments and physical conditions that will enable recovery of the corner.)

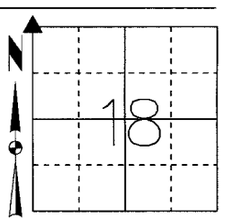

NORTHWEST CORNER
FOUND 5/8" REBAR WITH YPC UNREADABLE

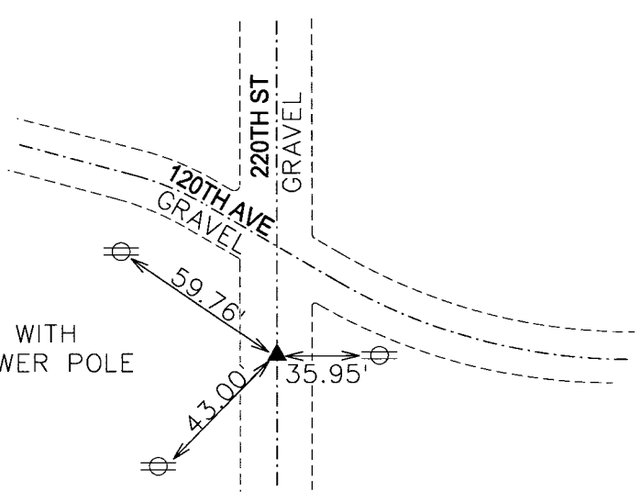

ALL TIES ARE SET NAIL WITH SURVEY MARKER IN POWER POLE

SLG
6/25/2013
F:\section_corners\skp_section_certificate\[wp_rng_sec_project_num\elk_wind (108.0378)\90_4_18_NW_1080378.dgn

NOTE: ALL DISTANCES MEASURED HORIZONTAL UNLESS OTHERWISE NOTED.

S&A Fnd 30

LICENSED LAND SURVEYOR
ERIC J. MILLER
19515
IOWA

I hereby certify that this land surveying document was prepared and the related survey work was performed by me or under my direct personal supervision and that I am a duly licensed Land Surveyor under the laws of the State of Iowa.

Eric J Mill 6-26-13

Eric J. Miller, PLS Date

License Number 19515

My License Renewal Date is December 31, 2014

Pages or sheets covered by this seal:

SHEET 1 OF 1

List Corners to be Indexed

Corners	Section	Twp	Range
NW CORNER	18	90	4
SW CORNER	7	90	4
SE CORNER	12	90	5
NE CORNER	13	90	5

TECH: SRM/EJM PN: 90-18-4-NW 108.0378 DATE: 6/20/13