Book 2014 Page 284

Document 2014 284 Type 06 007 Pages 1
Date 2/05/2014 Time 3:41:07PM
Rec Amt $7.00

DEBORAH L PEYTON, RECORDER/REGISTRAR
DELAWARE COUNTY IOWA

PREPARED BY: RANDALL L. RATTENBORG 105 WEST MAIN STREET MANCHESTER, IA 52057, 563-927-2434

UNITED STATES PUBLIC LAND SURVEY CORNER CERTIFICATE


Land Survey Monuments situated in Section 16, Township 87 North, Range 4 West of the Fifth Principal Meridian, Delaware County, Iowa.

Previously recorded in County Recorder's Office in BOOK 2012, PAGE 1454
(book, page, document number, etc.)

SE CORNER, Found 1/2" rebar w/orange cap #20281 buried 18" below gound in field. This Corner Certificate is being created due to previous tie points being buried by massive amounts of snow or the power poles had been replaced.

PLAN VIEW

(Show a minimum of three reference ties to durable physical objects, relevant monuments and physical conditions that will enable recovery of the corner.)

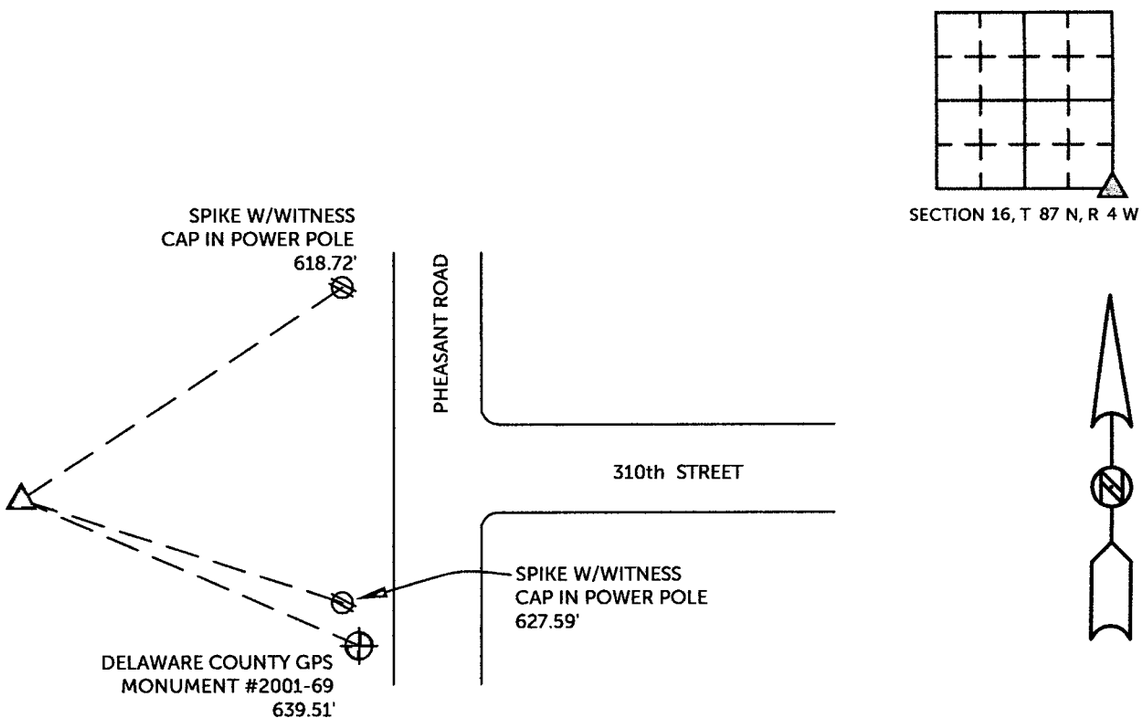

TIES ARE TO PLAT OF PARCEL 2014-08
IN SECTION 16, T 87 N, R 4 W

BURRINGTON GROUP, INC. PROJECT NO. 14-005

I HEREBY CERTIFY THAT THIS LAND SURVEYING DOCUMENT WAS PREPARED AND THE RELATED SURVEY WORK WAS PERFORMED BY ME OR UNDER MY DIRECT PERSONAL SUPERVISION AND THAT I AM A DULY LICENSED PROFESSIONAL LAND SURVEYOR UNDER THE LAWS OF THE STATE OF IOWA.

2/5/14

Randall L. Rattenborg, P.L.S. License #17939 Date

My license renewal date is December 31, 2015

List Corners to be Indexed:	Section	Township	Range
SE CORNER	16	T 87N	R 4 W

SEAL COVERS THIS SHEET ONLY

LICENSED PROFESSIONAL LAND SURVEYOR
RANDALL L. RATTENBORG
17939
IOWA

BURRINGTON GROUP, INC.
Civil Engineering | Land Surveying
105 W. Main Street Manchester, Iowa 52057