SEE ALSO SCC 05-18-21 2021-2034

93-1415
SLSI 9-90

UNITED STATES PUBLIC LAND SURVEY CORNER CERTIFICATE

OF


Land Survey Monuments situated in Section 1, Township 74 North, Range 28 West, of the Fifth Principal Meridian, Madison County, Iowa.
Previously recorded in N/A in County Recorder's Office.
(book, page, document number, etc.)


(Show reason for preparing this certificate, the evidence and detailed procedures used in establishing the corner positions and monumentation found or placed.)

Monument Description and Remarks: Monuments Found and Set as shown below.


PLAN - VIEW

(Show a minimum of three reference ties to durable physical objects, relevant monuments and physical conditions that will enable recovery of the corner.)

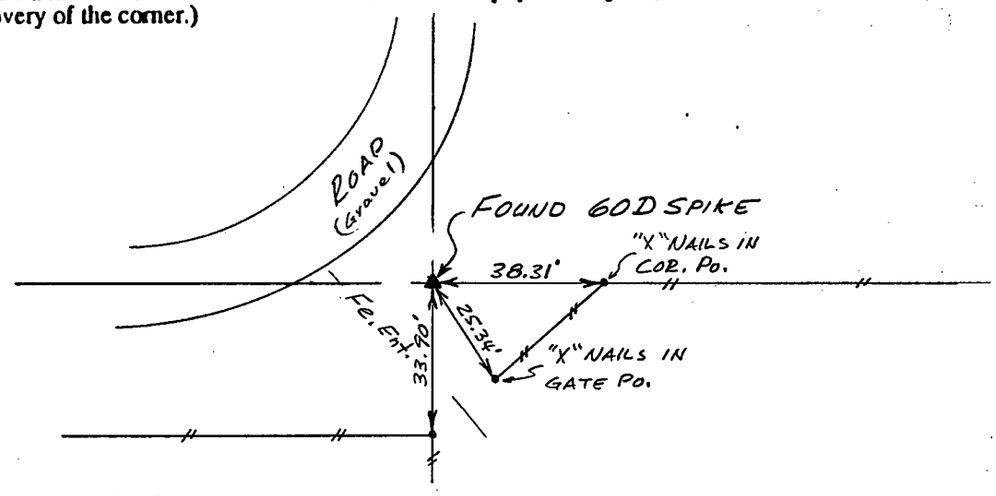


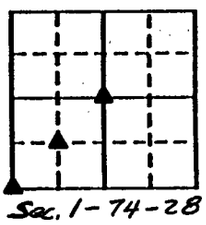

Ref. to CENTER OF SECTION 1, T74N, R28W.

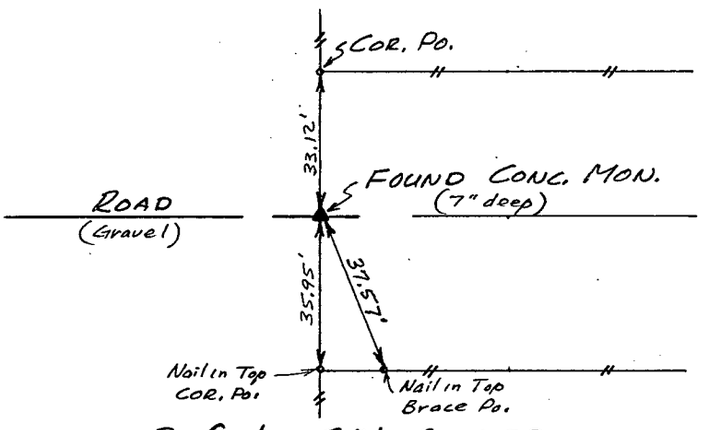

Ref. to SW. CORNER SECTION 1, T74N, R28W.

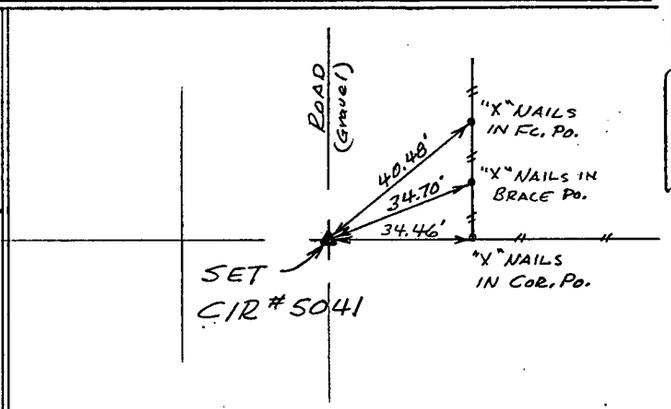

Ref. to NW. Cor., SE. 1/4 SW. 1/4, SECTION 1, T74N, R28W

I hereby certify that the survey work was completed and this certificate was prepared by me or under my direct personal supervision and that I am a duly registered land surveyor under the laws of the state of Iowa.

Signature: Charles T. Vance
Name typed or printed: Charles T. Vance, PE & LS
Date: 15 Dec, 1993 Reg. No. 5041

SEAL — PROFESSIONAL ENGINEER — REGISTERED — CHARLES T. VANCE 5041 — IOWA — LAND SURVEYOR

FILED NO. 1559
BOOK 1 PAGE 191
93 DEC 16 PM 4:01
MICHELLE UTSLER
RECORDER
MADISON COUNTY, IOWA

List Corners to be Indexed

Corners	Section	Twp	Range
CENTER	1	74	28
SW. Cor.	1	74	28
NW. Cor. SE. 1/4 SW. 1/4	1	74	28

REC $ 5.00
AUD $
R.M.F. $ 1.00

COMPUTER ✓
RECORDED ✓
COMPARED ✓