





Document 2019 2526

Book 2019 Page 2526 Type 06 026 Pages 1  
Date 8/15/2019 Time 10:08:54AM  
Rec Amt \$7.00

INDX  
ANNO  
SCAN

LISA SMITH, COUNTY RECORDER  
MADISON COUNTY IOWA

CHEK

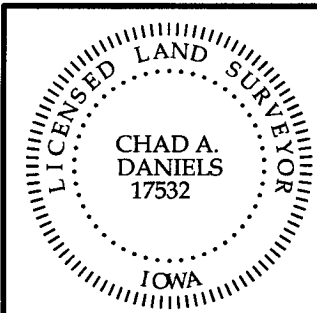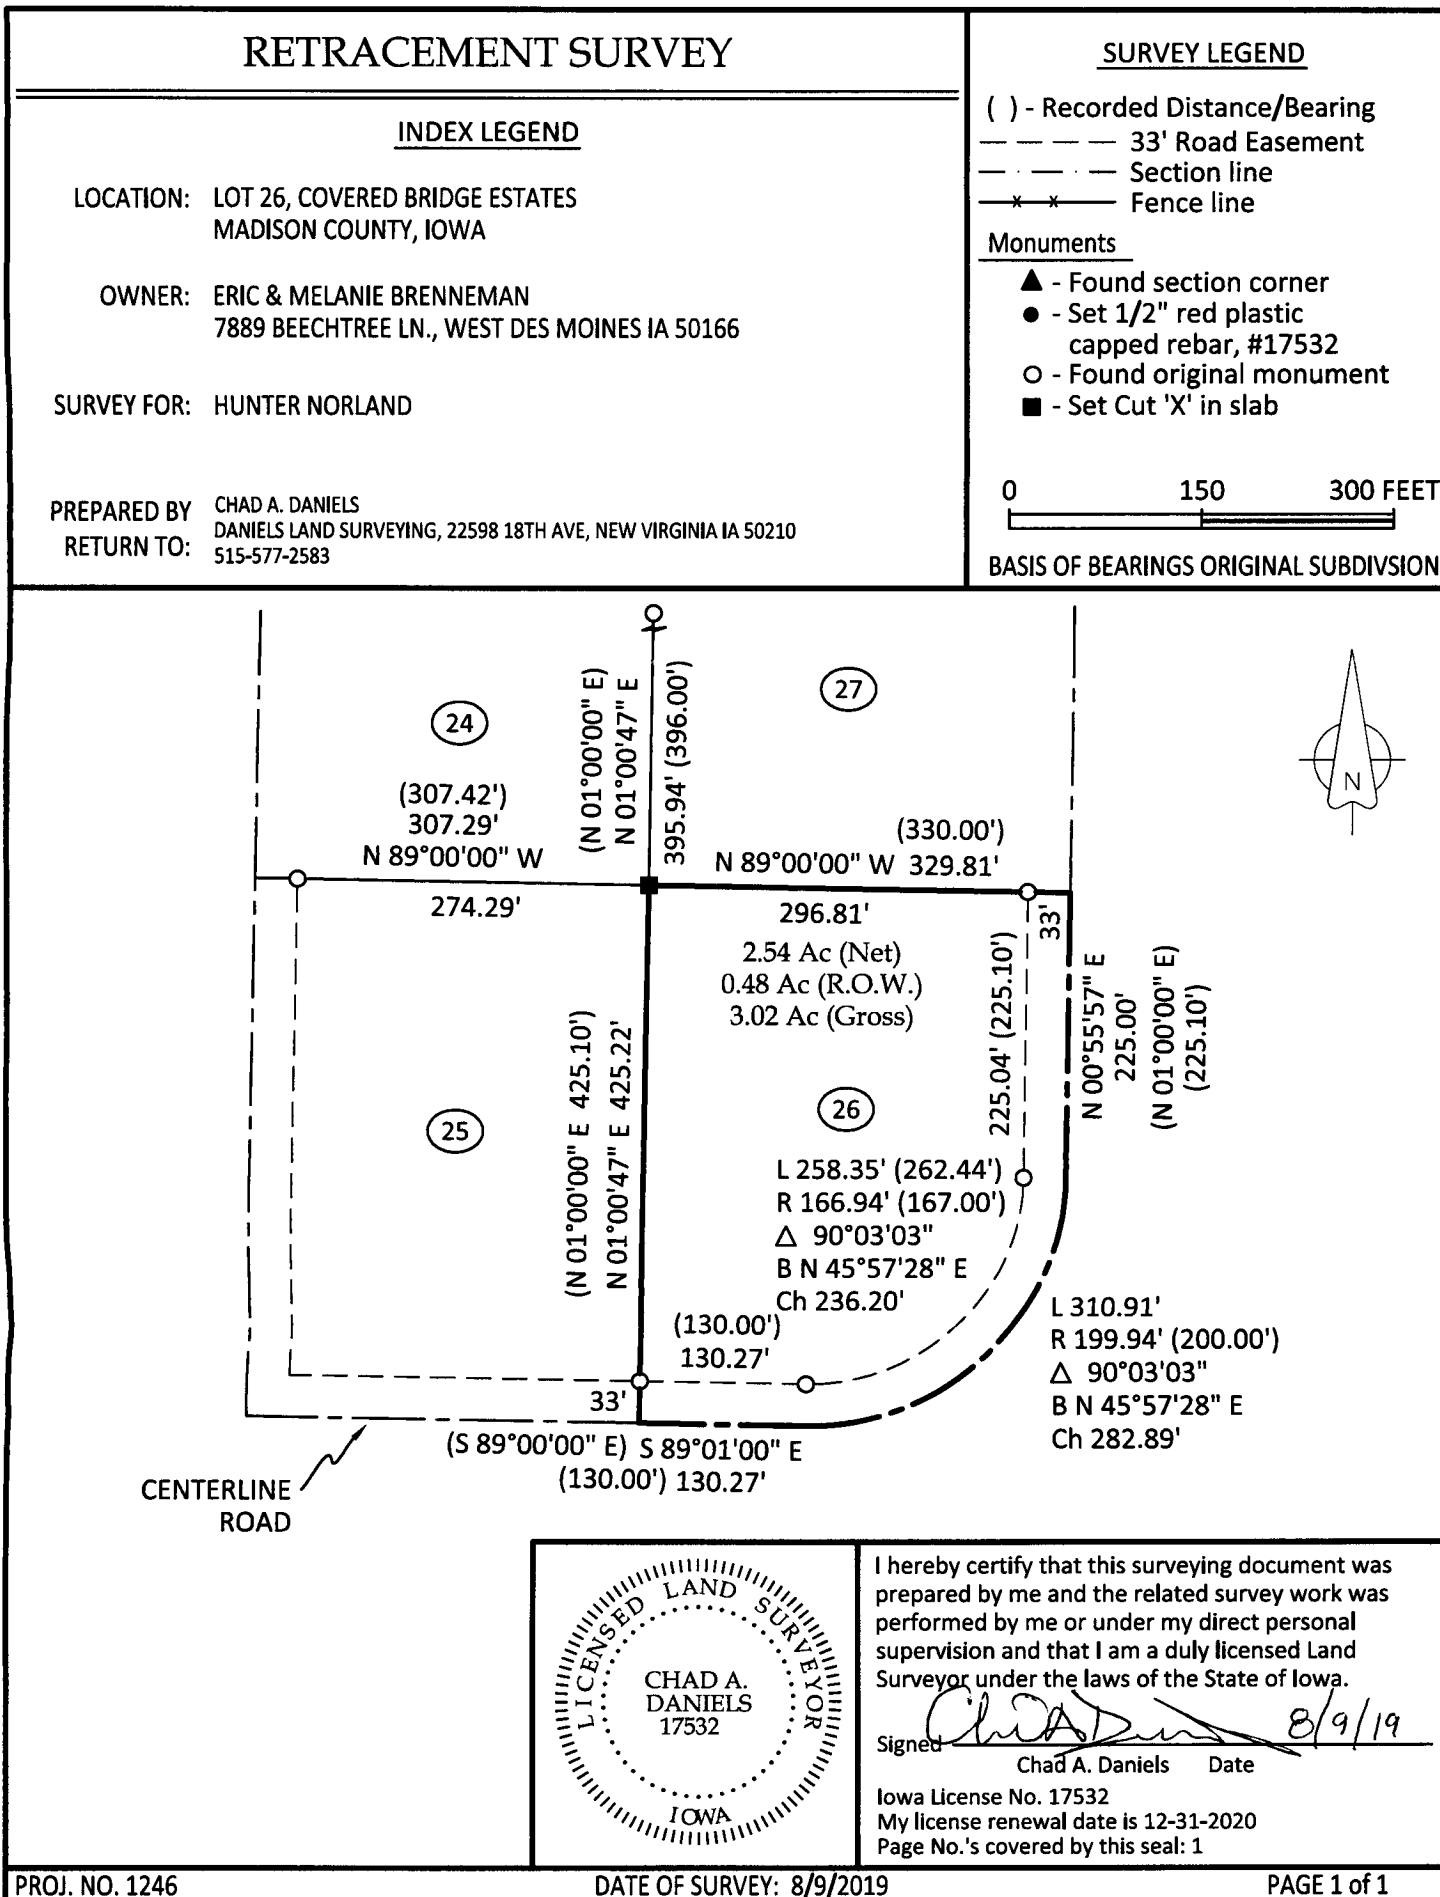

I hereby certify that this surveying document was prepared by me and the related survey work was performed by me or under my direct personal supervision and that I am a duly licensed Land Surveyor under the laws of the State of Iowa.

Signed 8/9/19  
Chad A. Daniels                      Date

Iowa License No. 17532  
My license renewal date is 12-31-2020  
Page No.'s covered by this seal: 1