

INDX  
ANNO  
SCAN  
CHEK

LISA SMITH, COUNTY RECORDER  
MADISON COUNTY IOWA

Prepared by: Vincent E. Piagentini, Abaci Consulting Inc, 3000 SE Grimes Blvd., Ste 800, Grimes IA, 50111; (515)986-5048

# UNITED STATES PUBLIC LAND SURVEY CORNER CERTIFICATE

of  
LAND SURVEY MONUMENTS SITUATED IN SECTION 22, TOWNSHIP 76 N, RANGE  
27 W, of the Fifth Principal Meridian, Madison County, Iowa.

### Monument Description & Remarks:


NE Cor - found 1/2" IR, No ties of record  
SE Cor NE1/4 NE1/4 - found 5/8" IR YC 7995, no ties of record

## PLAN VIEW

X Nails in Power Pole  
44.96' to pin

X Nails on Brace Post  
39.34' to pin

Nail w/ shiner on  
Corner Post  
38.35' to pin

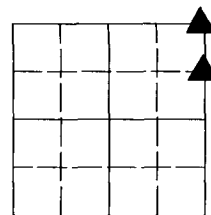

22-76-27

▲ ~5' West of centerline

NE Corner  
Sec 22-76-27  
1/2" IR



N.T.S.

X Nail w/ shiner on top  
of corner post  
33.63' to pin

Nail w/ Shiner in Power Pole  
60.35' to pin

Nail w/ Shiner in Power Pole  
43.40' to pin

SE Cor NE1/4 NE1/4  
Sec 22-76-27  
1/2" IR YC 7995

19201


I HEREBY CERTIFY THAT THIS SURVEYING DOCUMENT WAS PREPARED AND THE RELATED WORK WAS PERFORMED BY ME OR UNDER MY DIRECT PERSONAL SUPERVISION, AND THAT I AM A DULY LICENSED PROFESSIONAL LAND SURVEYOR UNDER THE LAWS OF THE STATE OF IOWA.

*Vincent E. Piagentini* 9/17/19

VINCENT E. PIAGENTINI, IOWA LIC. NO 15982 DATE

MY LICENSE RENEWAL DATE IS DECEMBER 31, 2020.

ADDITIONAL PAGES CERTIFIED (NONE UNLESS INDICATED HERE) This sheet only.

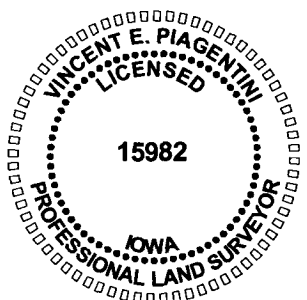

Corners to be Indexed:			
Corner	Section	Twp	Range
NE Cor	22	T76N	R27W
NW Cor	23	T76N	R27W
SE Cor	15	T76N	R27W
SW Cor	14	T76N	R27W
SE Cor NE1/4	NE 22	T76N	R27W
SW Cor NW1/4	NW 23	T76N	R27W