BOUNDARY RETRACEMENT SURVEY INDEX LEGEND COUNTY: Madison SITE ADDRESS: Quail Ridge Avenue
CITY: Winterset
SECTION: 23 TOWNSHIP: 76 RANGE:27
ALIQUOT PART: NW1/4 NE1/4
SUBDIVISION NAME: Quail Ridde Subdivision
BLOCK: LOT(S): 16 Rec Amt \$7.00 LOT(S): 16

Book 2020 Page 2300 Type 06 026 Pages 1 Date 6/29/2020 Time 11:11:06AM

INDX **ANNO** SCAN

LISA SMITH, COUNTY RECORDER MADISON COUNTY IOWA

CHEK


THIS SPACE RESERVED FOR RECORDER'S OFFICE USE ONLY

PREPARED BY & RETURN TO: ABACI CONSULTING INC, 3000 SE GRIMES BLVD, STE 800, GRIMES, IA 50111, PH(515)986-5048

PROPRIETOR: Justin & Ann Doyle REQUESTED BY:Justin Doyle

SURVEYOR NAME: Vincent E. Piagentini

Legal Description Lot 16 in Quail Ridge Subdivision, an Official Plat, now included in and forming a part of Madison County, lowa

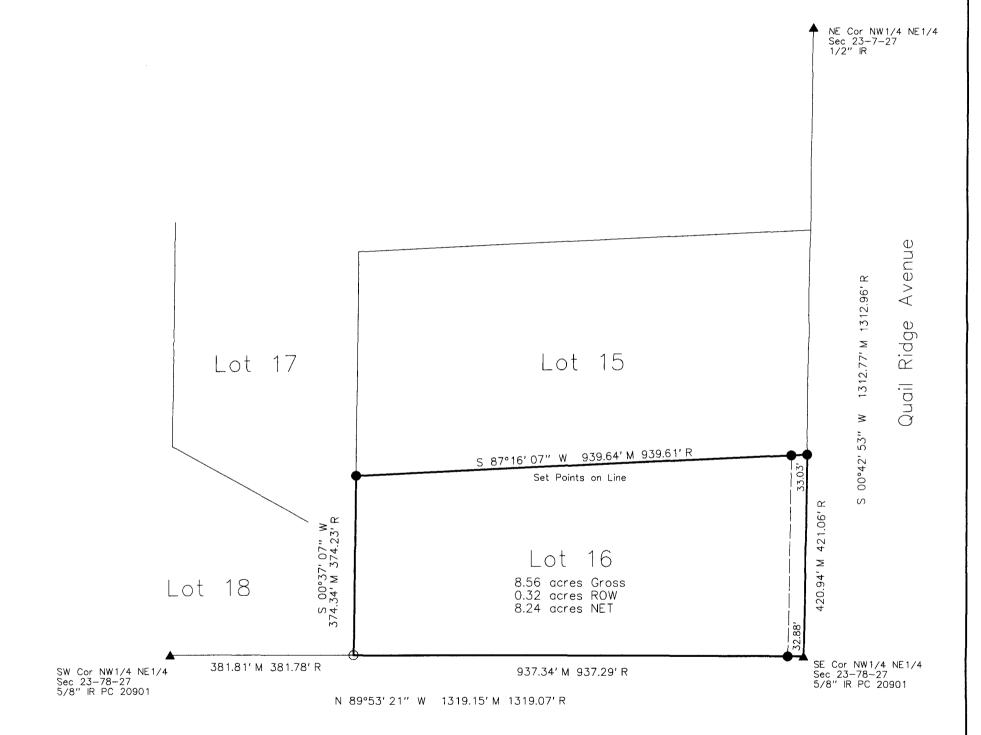

ABACI CONSULTING, INC.

CIVIL ENGINEERING - LAND SURVEYING 3000 SE Grimes Blvd., Ste 800, GRIMES, IOWA 50111, PH. (515)986-5048


DATE OF SURVEY FIELDWORK: 6/23/20 DRAWING DATE: 6/26/20 DRAFTER: VP PROJECT NO: 20247

I HEREBY CERTIFY THAT THIS SURVEYING DOCUMENT WAS PREPARED AND THE RELATED WORK WAS PERFORMED BY ME OR UNDER MY DIRECT PERSONAL SUPERVISION, AND THAT I AM A DULY LICENSED PROFESSIONAL LAND SURVEYOR

VINCENT E. PIAGENTINI, IOWA LIC. NO 15982

MY LICENSE RENEWAL DATE IS DECEMBER 31, 2020.

ADDITIONAL PAGES CERTIFIED (NONE UNLESS INDICATED

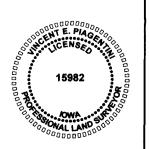

SYMBOLS LEGEND: PLS LEGEND:
RECORDED DISTANCE
MEASURED DISTANCE
CALCULATED DISTANCE
FOUND 5/8" IR PC 20901
UNLESS NOTED
SET 1/2" IR YC 15982
UNLESS NOTED
SECTION CORNER SET C 0 ▲

SECTION CORNER SET
1/2" IR YC 15982
UNLESS NOTED
POINT OF BEGINNING
POINT OF COMMENCEMENT \triangle

YELLOW CAP PINK CAP IRON ROD IRON PIPE

