

INDEX LEGEND



Document 2020 417

Location:: S19-T74-R26 of the 5th P.M.

Book 2020 Page 417 Type 06 026 Pages 1

Requestor: Jessica Salcedo

Date 2/07/2020 Time 3:52:00PM

Proprietor: Gabriel & Jessica Salcedo

Rec Amt \$7.00

INDX
ANNO
SCAN

Project: 20002 Date of Survey: 1/8/2020


Surveyor Co: Boldman Surveying Consultants

LISA SMITH, COUNTY RECORDER
MADISON COUNTY IOWA

CHEK


✓ Prepared by/Return to: Craig S. Boldman
521 West Green Street, Winterset, Ia 50273
Phone/fax: 515-462-9242

RETRACEMENT SURVEY of Lot 1 in Cummings Park Plat No. 1, an Official Plat located in part of the NE 1/4 of Section 19, Township 74, Range 26 West of the 5th P.M., Madison County, Iowa

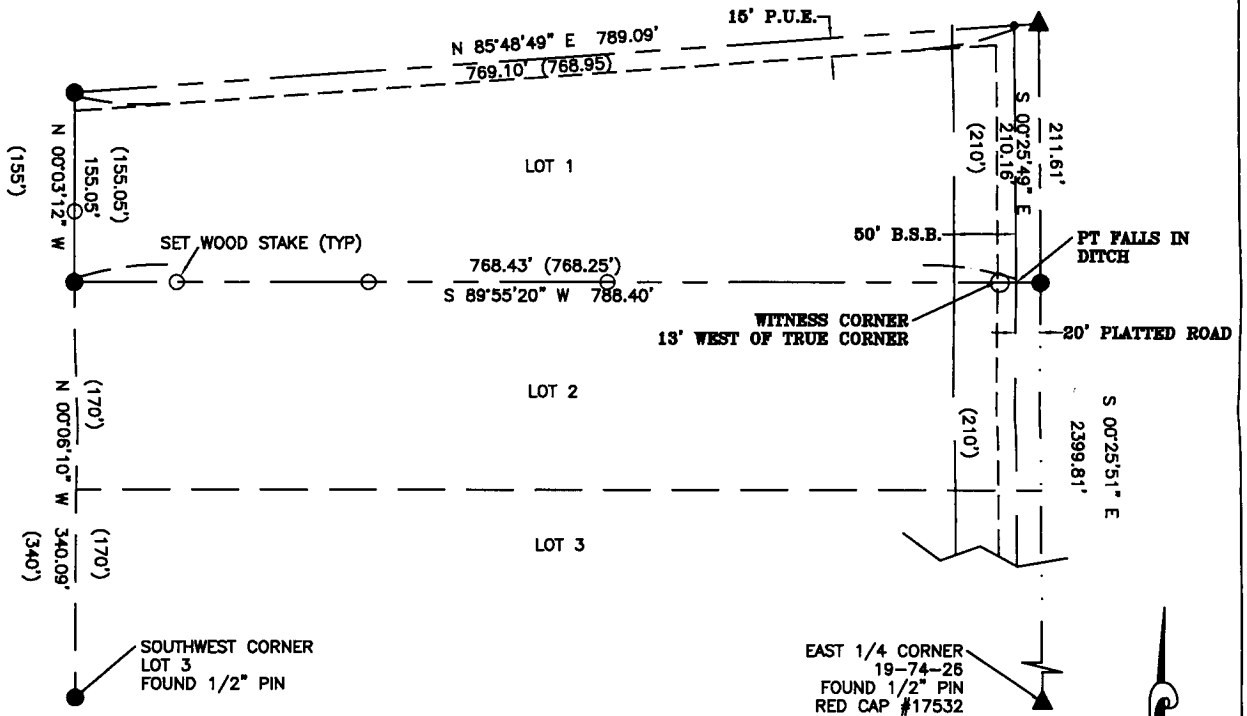

- IRON ROD OR PIPE SET
- IRON ROD FOUND
- ▲ PLSS CORNER FOUND

P.U.E.-PUBLIC UTILITY EASEMENT
B.S.L.-BUILDING SETBACK LINE
(100') RECORD PLAT /TITLE DISTANCE

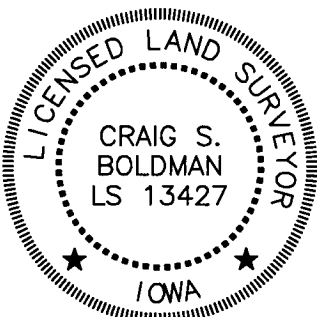

I hereby certify that this land surveying document was prepared and the related survey work was performed by me or under my direct supervision and that I am a duly licensed Land Surveyor under the laws of the State of Iowa

Signature *Craig S. Boldman* Date 2/7/2020

Name Craig S. Boldman P.L.S No. 13427

Renewal date is December 31, 2020

Pages or sheets covered by this seal 1