

REAL ESTATE TRANSFER - GROUNDWATER HAZARD STATEMENT
TO BE COMPLETED BY TRANSFEROR

TRANSFEROR: (seller)

Name David Enos. Jr. & Elaine Stutsman

Address 406 NW Rock Creek Cir., Ankeny, IA 50023
Number and Street or RR City, Town or P.O. State Zip

TRANSFeree: (buyer)

Name Kelly & Amanda Flinn

Address 3332 105th St., Cumming, IA 50061
Number and Street or RR City, Town or P.O. State Zip

Address of Property Transferred:

n/a/ rural
Number and Street or RR City, Town or P.O. State Zip

Legal Description of Property: (Attach if necessary)

The Southeast Quarter (1/4) of the Northwest Quarter (1/4) of Section One (1), Township Seventy-seven (77) North, Range Twenty-six (26) West of the 5th P.M., Madison County, Iowa, INCLUDING Parcel "A" located therein, containing 3.471 acres, as shown in Plat of Survey filed in Book 2, Page 419 on October 8, 1993, in the Office of the Recorder of Madison County Iowa; EXCEPT Parcel "B" located therein, containing 3.001 acres, as shown in Plat of Survey filed in Book 3, Page 491 on September 15, 1999, in the Office of the Recorder of Madison County, Iowa; AND EXCEPT Parcel "F" located therein, containing 0.138, as shown in Plat of Survey filed in Book 2006, Page 3082 on July 27, 2006, in the Office of the Recorder of Madison County, Iowa; AND EXCEPT all that part of the North Sixty-five (65) acres of the East Half (1/2) of the Northwest Quarter (1/4) of said Section One (1) located therein

1. Wells (check one)

There are no known wells situated on this property.

There is a well or wells situated on this property. The type(s), location(s) and legal status are stated below or set forth on an attached separate sheet, as necessary.

2. Solid Waste Disposal (check one)

There is no known solid waste disposal site on this property.

There is a solid waste disposal site on this property and information related thereto is provided in Attachment #1, attached to this document.

3. Hazardous Wastes (check one)

There is no known hazardous waste on this property.

There is hazardous waste on this property and information related thereto is provided in Attachment #1, attached to this document.

4. Underground Storage Tanks (check one)

There are no known underground storage tanks on this property. (Note exclusions such as small farm and residential motor fuel tanks, most heating oil tanks, cisterns and septic tanks, in instructions.)

There is an underground storage tank on this property. The type(s), size(s) and any known substance(s) contained are listed below or on an attached separate sheet, as necessary.

5. Private Burial Site (check one)

There are no known private burial sites on this property.

There is a private burial site on this property. The location(s) of the site(s) and known identifying information of the decedent(s) is stated below or on an attached separate sheet, as necessary.

6. Private Sewage Disposal System (check one)

All buildings on this property are served by a public or semi-public sewage disposal system.

This transaction does not involve the transfer of any building which has or is required by law to have a sewage disposal system.

There is a building served by private sewage disposal system on this property or a building without any lawful sewage disposal system. A certified inspector's report is attached which documents the condition of the private sewage disposal system and whether any modifications are required to conform to standards adopted by the Department of Natural Resources. A certified inspection report must be accompanied by this form when recording.

There is a building served by private sewage disposal system on this property. Weather or other temporary physical conditions prevent the certified inspection of the private sewage disposal system from being conducted. The buyer has executed a binding acknowledgment with the county board of health to conduct a certified inspection of the private sewage disposal system at the earliest practicable time and to be responsible for any required modifications to the private sewage disposal system as identified by the certified inspection. A copy of the binding acknowledgment is attached to this form.

There is a building served by private sewage disposal system on this property. The buyer has executed a binding acknowledgment with the county board of health to install a new private sewage disposal system on this property within an agreed upon time period. A copy of the binding acknowledgment is provided with this form.


There is a building served by private sewage disposal system on this property. The building to which the sewage disposal system is connected will be demolished without being occupied. The buyer has executed a binding acknowledgment with the county board of health to demolish the building within an agreed upon time period. A copy of the binding acknowledgment is provided with this form. [Exemption #9]

This property is exempt from the private sewage disposal inspection requirements pursuant to the following exemption [Note: for exemption #9 use prior check box]:


The private sewage disposal system has been installed within the past two years pursuant to permit number 078-20.

Information required by statements checked above should be provided here or on separate sheets attached hereto:

I HEREBY DECLARE THAT I HAVE REVIEWED THE INSTRUCTIONS FOR THIS FORM AND THAT THE INFORMATION STATED ABOVE IS TRUE AND CORRECT.

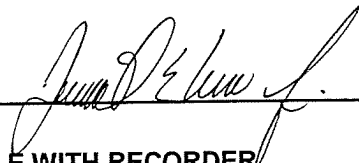Signature: 

Telephone No.: 515-498-9929

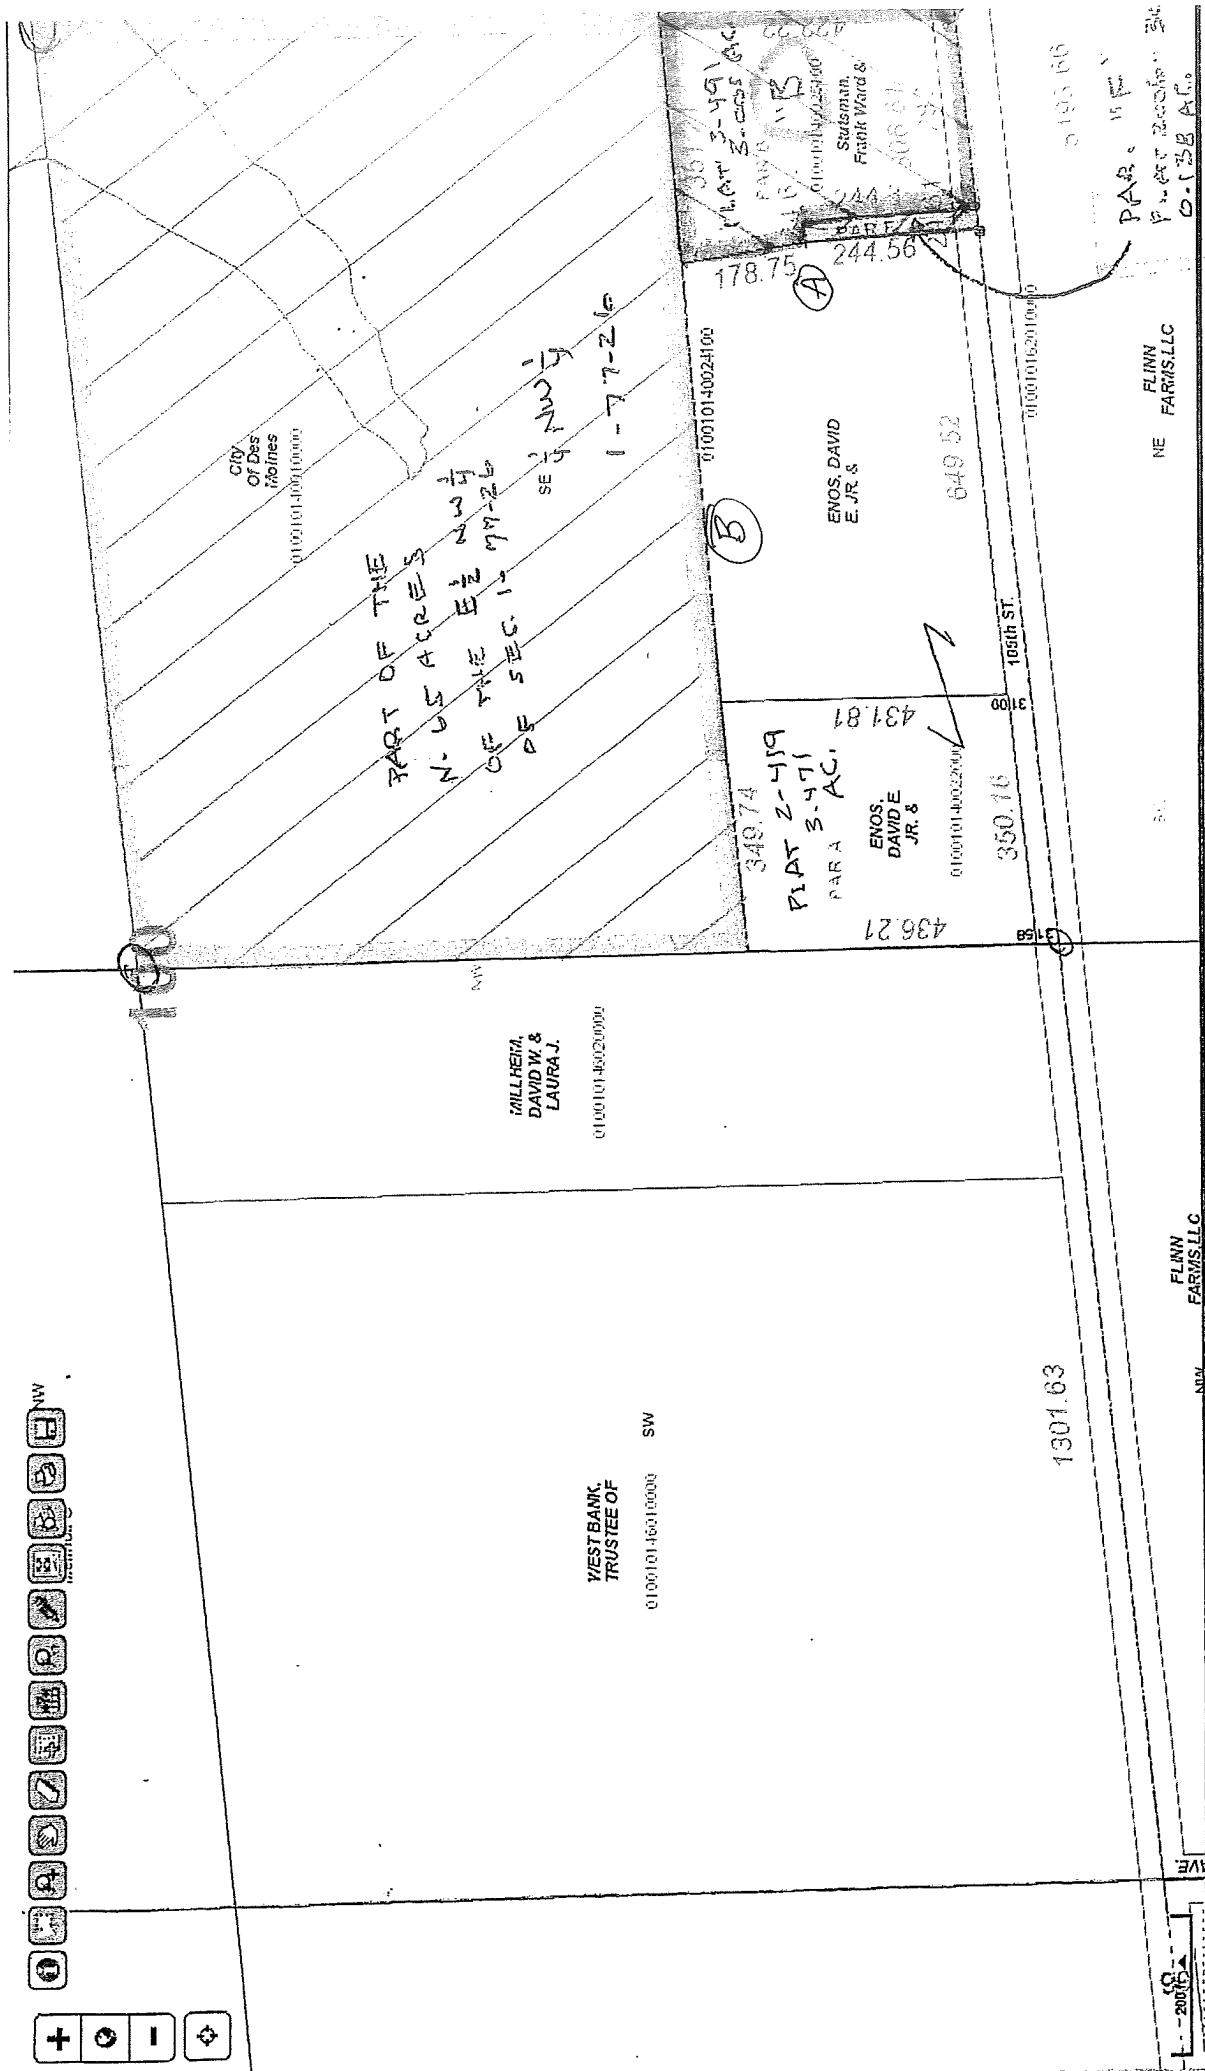

- (A) LIVESTOCK WELL #1 50'
- (B) LIVESTOCK WELL #2 80'

2/5/20
 # 01772642

THIS AERIAL MAP FROM THE ASSESSOR'S WEBSITE IS BEING PROVIDED AS AN AID TO THE EXAMINING ATTORNEY. PLEASE RETAIN WITH ABSTRACT.

COURTESY OF MADISON COUNTY ABSTRACT CO.