



Document 2021 126

Book 2021 Page 126 Type 06 043 Pages 1
Date 1/11/2021 Time 11:16:33AM
Rec Amt \$7.00

INDX
ANNO
SCAN
CHEK

LISA SMITH, COUNTY RECORDER
MADISON COUNTY IOWA

Prepared by: Vincent E. Piagentini, Abaci Consulting Inc, 3000 SE Grimes Blvd., Ste 800, Grimes IA, 50111; (515)986-5048

UNITED STATES PUBLIC LAND SURVEY CORNER CERTIFICATE

of

LAND SURVEY MONUMENTS SITUATED IN SECTION 16, TOWNSHIP 74 N, RANGE 29 W, of the Fifth Principal Meridian, Madison County, Iowa.


Monument Description & Remarks:

E1/4 Corner - Found Nail Shaft in Asphalt - No tie of Record

NE Cor NW1/4 SW1/4 - Searched, found nothing - Set Mag Nail - Set online between E1/4 and W1/4, North of Fence Running South

NE Cor NW1/4 SW1/4 - Searched, found nothing - Set 1/2" IR YC 15982 - Set on SE corner of fence post, fences running West and North

PLAN VIEW

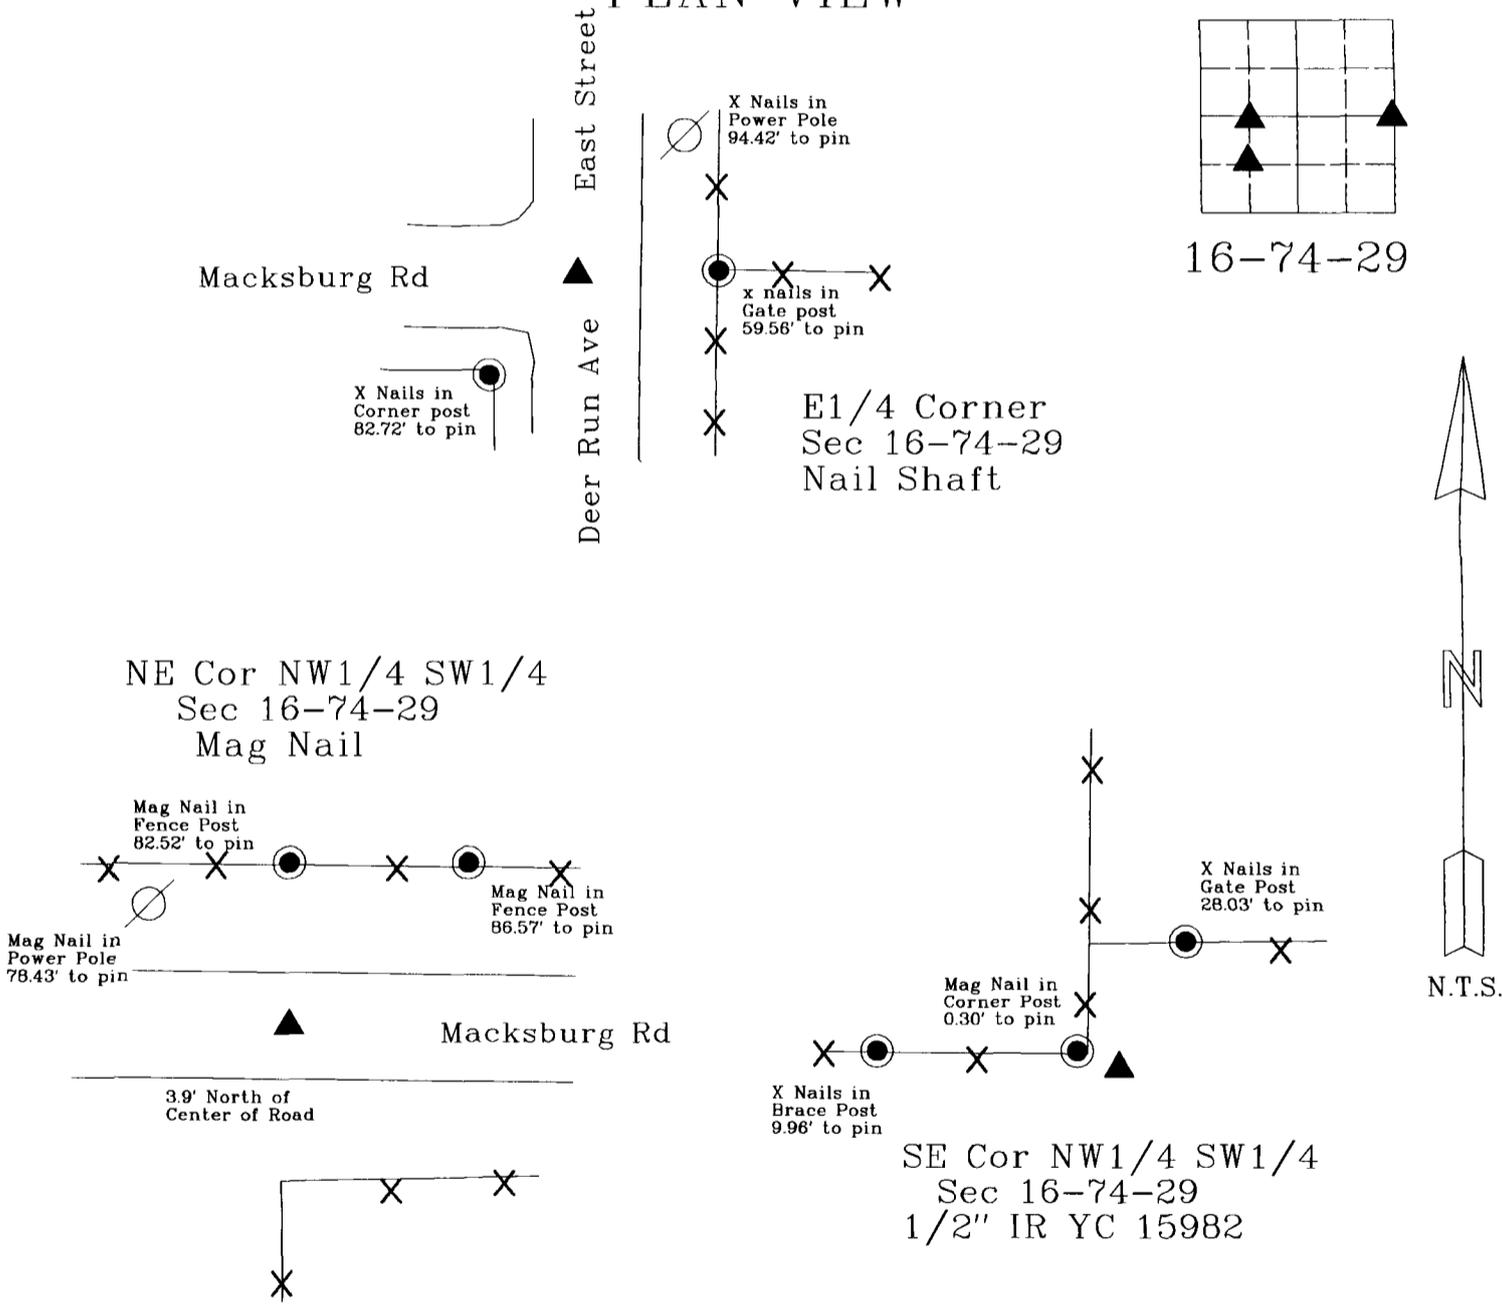

20435

I HEREBY CERTIFY THAT THIS SURVEYING DOCUMENT WAS PREPARED AND THE RELATED WORK WAS PERFORMED BY ME OR UNDER MY DIRECT PERSONAL SUPERVISION, AND THAT I AM A DULY LICENSED PROFESSIONAL LAND SURVEYOR UNDER THE LAWS OF THE STATE OF IOWA.

Vincent E. Piagentini 1/6/2021
VINCENT E. PIAGENTINI, IOWA LIC. NO 15982 DATE

MY LICENSE RENEWAL DATE IS DECEMBER 31, 2022.

ADDITIONAL PAGES CERTIFIED (NONE UNLESS INDICATED HERE)

This sheet only.



Corners to be Indexed:

Corner	Section	Twp	Range
E1/4 Corner	16	T74N	R29W
W1/4 Corner	15	T74N	R29W
SE Cor NW1/4 SW1/4	16	T74N	R29W
NE Cor NW1/4 SW1/4	16	T74N	R29W