

BK: 2021 PG: 3048
 Recorded: 7/21/2021 at 3:36:43.0 PM
 Pages: 3
 County Recording Fee: \$17.00
 Iowa E-Filing Fee: \$3.32
 Combined Fee: \$20.32
 Revenue Tax:
 LISA SMITH RECORDER
 Madison County, Iowa

RETRACEMENT SURVEY

SE 1/4 SE 1/4, SW 1/4 SE 1/4, SE 1/4 SW 1/4

SECTION 01-76-26

MADISON COUNTY, IOWA

Civil Engineering Consultants, Inc.
 2400 86th Street, Unit 12 · Des Moines, Iowa 50322
 515.276.4884 · mail@cecinc.com




DATE: JULY 21, 2021
 DATE OF SURVEY: JUN 16, 2021
 DESIGNED BY: P. J.
 DRAWN BY: P. J.

SE 1/4 SW 1/4 - SW 1/4 SE 1/4 - SE 1/4 SE 1/4 SECTION 01-76-26
 RETRACEMENT SURVEY
 MADISON COUNTY, IOWA
 COVER

SHEET
 OF 3
 E2644

INDEX LEGEND						
COUNTY: MADISON						
ALLOT PART:	SECTION	TOWNSHIP	RANGE	1/4	1/4	
	1	76	26	SE	SE	
	1	76	26	SW	SE	
	1	76	26	SE	SW	
PROPRIETOR IS: ELIZABETH BOLTON						
REQUESTED BY: ELIZABETH BOLTON						
PROFESSIONAL LAND SURVEYOR: PATRICK J. SHEPARD, PLS 12265						
COMPANY: CIVIL ENGINEERING CONSULTANTS, INC. ATTN: PATRICK J. SHEPARD 2400 86TH STREET, SUITE 12, IRBANDALE, IA 50322 PHONE: 515-276-4884						

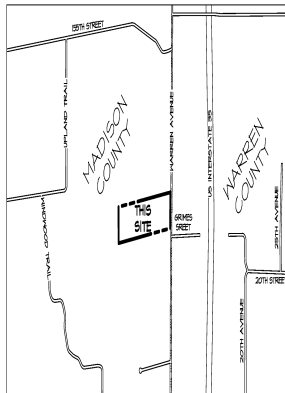

VICINITY SKETCH

DRAWING INDEX

- COVER
- BOUNDARY DIMENSION OVERALL
- RETRACEMENT SURVEY

PROPERTY OWNERS:
 ELIZABETH BOLTON
 4832 WASHBURN AVE S
 MINNEAPOLIS, MN 55410

PREPARED FOR:
 ELIZABETH BOLTON
 4832 WASHBURN AVE S
 MINNEAPOLIS, MN 55410

PROPERTY ADDRESS:
 1814 WARREN AVENUE

PROFESSIONAL LAND SURVEYOR:
 CIVIL ENGINEERING CONSULTANTS, INC.
 ATTN: PATRICK J. SHEPARD, PLS
 2400 86TH STREET, SUITE 12
 IRBANDALE, IA 50322
 PHONE: 515-276-4884
 EMAIL: SHEPARD@CEC.IA.GOV

PARCEL ID:
 430020186000000

LEGAL DESCRIPTION: ENTIRE PARCEL
 WARRANTY DEED BOOK 2021, PAGE 1028

THE WEST HALF (1/2) OF THE SOUTHEAST FRACTIONAL QUARTER (1/4) OF THE SOUTHWEST FRACTIONAL QUARTER (1/4) OF SECTION ONE (1), TOWNSHIP SEVENTY-SIX (76) NORTH, RANGE TWENTY-SIX (26) WEST OF THE 5TH PM, MADISON COUNTY, IOWA.

AND

THE SOUTH FRACTIONAL HALF (1/2) OF THE SOUTHEAST FRACTIONAL QUARTER (1/4) AND THE EAST HALF (1/2) OF THE SOUTHEAST FRACTIONAL QUARTER (1/4) OF THE SOUTHWEST FRACTIONAL QUARTER (1/4) OF SECTION ONE (1), TOWNSHIP SEVENTY-SIX (76) NORTH, RANGE TWENTY-SIX (26) WEST OF THE 5TH PM, MADISON COUNTY, IOWA.

BASIS OF BEARINGS:

THE EAST LINE OF THE SE 1/4 OF SECTION 1-76-26 WAS MEASURED AS HAVING A BEARING OF S00°20'40"N. THIS BEARING WAS DETERMINED FROM THE IOWA DEPARTMENT OF TRANSPORTATION REAL-TIME NETWORK CONVERTED TO IOWA STATE PLANE NAD83(2011) SOUTH ZONE GRID NORTH.

NOTES:

- THIS PARCEL MAY BE SUBJECT TO EASEMENTS OF RECORD. NO TITLE WORK WAS PROVIDED TO THIS LAND SURVEYOR.
- THE UNADJUSTED ERROR OF CLOSURE IS NOT GREATER THAN 1/10000 FOR SUBDIVISION BOUNDARIES AND IS NOT GREATER THAN 1/3000 FOR INDIVIDUAL LOTS.
- MONUMENTS TO BE SET WITHIN THIRTY DAYS OF THE DATE OF SURVEY RECORDING DATE.

PURPOSE FOR SURVEY:

THIS SURVEY IS BEING PREPARED TO CREATE NEW PARCELS.

LAND AREA:

BOUNDARY	GROSS (ACRES)	PUBLIC R.O.M. EASEMENT (ACRES)	NET (ACRES)
SE SE	38.80	1.25	37.55
SW SE	38.84		38.84
SE SW	38.80		38.80
TOTAL	116.04	1.25	114.84

LEGEND

- ▲ FOUND SECTION CORNERS
- △ SET SECTION CORNER (5'x) I.R. (NORANGE CAP #12265 (UNLESS OTHERWISE NOTED))
- FOUND CORNERS
- SET PROPERTY CORNER (5'x) I.R. (NORANGE CAP #12265 (UNLESS OTHERWISE NOTED))
- PROPERTY BOUNDARY LINES
- PARCEL LINES
- COUNTY LINE
- EXISTING LOT OR TAX PARCEL LINES
- ORIGINAL PLAT LOT LINES
- EASEMENT LINES
- CHAIN LINK FENCE
- HOOD FENCE
- D. DEEDED BEARINGS & DISTANCE
- P. PREVIOUSLY RECORDED BEARINGS & DISTANCE
- M. MEASURED BEARINGS & DISTANCE
- IR. IRON ROD
- IP. IRON PIPE
- BK. XXX, PG. XXX COUNTY RECORDS' INDEXING BOOK
- B.S.L. BUILDING SETBACK LINE
- P.U.E. PUBLIC UTILITY EASEMENT
- I.E.E. INGRESS/EGRESS EASEMENT
- R.O.W. RIGHT-OF-WAY
- P.O.B. POINT OF BEGINNING
- (30) ADDRESS

FEMA F.I.R.M. CLASSIFICATION

THIS PARCEL LIES WITHIN FLOOD ZONE 'X', 'X', 'X', 'X', 'X' (SHADE) BEING IDENTIFIED ON FEMA FLOOD INSURANCE RATE MAP NO. 160200020D WITH EFFECTIVE DATE OF JUNE 21, 2017 & FEMA FLOOD INSURANCE RATE MAP NO. 160200020D (NOT PRINTED) WITH EFFECTIVE DATE OF NOVEMBER 15, 2018.

COMMUNITY	NUMBER	PANEL	SUFFIX
MADISON COUNTY	10281	0200	D

SURVEYOR NOTES:

- THE ORIGINAL G.L.O. PLAT HAS A DISCREPANCY IN ACRES.
- THE NW CORNER OF SECTION 1 WAS SET AT AN OLD CORNER POST THAT HAS A FENCE RUNNING NORTH EAST AND WEST.
- THE SW CORNER OF SECTION 1 WAS SET BY USING THE PLATTED G.L.O. DISTANCE AND A BEST FIT LINEAR REGRESSION OF THE FENCE LINE RUNNING ALONG THE SOUTH LINE OF SECTION 1 AND HOLDING THE SE CORNER OF SAID SECTION.
- THE SW 1/4 CORNER OF SECTION 1 WAS SET BY USING THE PLATTED G.L.O. DISTANCE AND THE LINE BETWEEN THE SE CORNER AND A FOUND CORNER AT THE SW CORNER, SE 1/4 SW 1/4 SECTION 1. THIS LINE MATCHES THE EXISTING FENCE LINE.
- THE NW 1/4 CORNER OF SECTION 1 WAS SET AT A PROPORTED DISTANCE AND AN LINE BETWEEN THE NW CORNER AND SW CORNER OF SECTION 1.

CERTIFICATION

I HEREBY CERTIFY THAT THE LAND SURVEYING DOCUMENT WAS PREPARED AND THE RELATED SURVEY WORK WAS PERFORMED BY ME OR UNDER MY DIRECT PERSONAL SUPERVISION AND THAT I AM A FULLY LICENSED PROFESSIONAL LAND SURVEYOR UNDER THE LAWS OF THE STATE OF IOWA.

PATRICK J. SHEPARD
 12265
 PLS

DATE: 07-21-21
 IOWA LICENSE NO. 12265
 MY LICENSE RENEVAL DATE IS DECEMBER 3, 2022

PAGES OR SHEETS COVERED BY THIS SEAL: 1-3

