



Document 2021 GW4093

Book 2021 Page 4093 Type 43 001 Pages 4

Date 10/01/2021 Time 11:52:08AM

Rec Amt \$.00

INDX
ANNO
SCAN

LISA SMITH, COUNTY RECORDER
MADISON COUNTY IOWA

CHEK

**REAL ESTATE TRANSFER - GROUNDWATER HAZARD STATEMENT
TO BE COMPLETED BY TRANSFEROR**

TRANSFEROR:

Name: Doreen A. Price

Address: 1509 Heritage Avenue, Earlham, IA 50072

TRANSFeree:

Name: Johnathan Tyler Price

Address: 435 NE Cedar Avenue, Earlham, IA 50072

Address of Property Transferred:

1509 Heritage Avenue, Earlham, Iowa 50072

Legal Description of Property: (Attach if necessary)

The Northeast Quarter of the Northeast Quarter of Section 31, Township 77 North, Range 28, West of the 5th P.M., Madison County, Iowa

1. Wells (check one)

There are no known wells situated on this property.

There is a well or wells situated on this property. The type(s), location(s) and legal status are stated below or set forth on an attached separate sheet, as necessary.

2. Solid Waste Disposal (check one)

There is no known solid waste disposal site on this property.

There is a solid waste disposal site on this property and information related thereto is provided in Attachment #1, attached to this document.

3. Hazardous Wastes (check one)

There is no known hazardous waste on this property.

There is hazardous waste on this property and information related thereto is provided in Attachment #1, attached to this document.

4. Underground Storage Tanks (check one)

There are no known underground storage tanks on this property. (Note exclusions such as small farm and residential motor fuel tanks, most heating oil tanks, cisterns and septic tanks, in instructions.)

There is an underground storage tank on this property. The type(s), size(s) and any known substance(s) contained are listed below or on an attached separate sheet, as necessary.

5. Private Burial Site (check one)

There are no known private burial sites on this property.

There is a private burial site on this property. The location(s) of the site(s) and known identifying information of the decedent(s) is stated below or on an attached separate sheet, as necessary.

6. Private Sewage Disposal System (check one)

- All buildings on this property are served by a public or semi-public sewage disposal system.
- This transaction does not involve the transfer of any building which has or is required by law to have a sewage disposal system.
- There is a building served by private sewage disposal system on this property or a building without any lawful sewage disposal system. A certified inspector's report is attached which documents the condition of the private sewage disposal system and whether any modifications are required to conform to standards adopted by the Department of Natural Resources. A certified inspection report must be accompanied by this form when recording.
- There is a building served by private sewage disposal system on this property. Weather or other temporary physical conditions prevent the certified inspection of the private sewage disposal system from being conducted. The buyer has executed a binding acknowledgment with the county board of health to conduct a certified inspection of the private sewage disposal system at the earliest practicable time and to be responsible for any required modifications to the private sewage disposal system as identified by the certified inspection. A copy of the binding acknowledgment is attached to this form.
- There is a building served by private sewage disposal system on this property. The buyer has executed a binding acknowledgment with the county board of health to install a new private sewage disposal system on this property within an agreed upon time period. A copy of the binding acknowledgment is provided with this form.
- There is a building served by private sewage disposal system on this property. The building to which the sewage disposal system is connected will be demolished without being occupied. The buyer has executed a binding acknowledgment with the county board of health to demolish the building within an agreed upon time period. A copy of the binding acknowledgment is provided with this form. [Exemption #9]
- This property is exempt from the private sewage disposal inspection requirements pursuant to the following exemption [Note: for exemption #9 use prior check box]: #5.
- The private sewage disposal system has been installed within the past two years pursuant to permit number _____.


Information required by statements checked above should be provided here or on separate sheets attached hereto:

**I HEREBY DECLARE THAT I HAVE REVIEWED THE INSTRUCTIONS
FOR THIS FORM AND THAT THE INFORMATION STATED
ABOVE IS TRUE AND CORRECT.**

Signature: Doreen A. Price Telephone No.: 515-249-4147
(Transferor)

GROUNDWATER HAZARD STATEMENT

Well Location

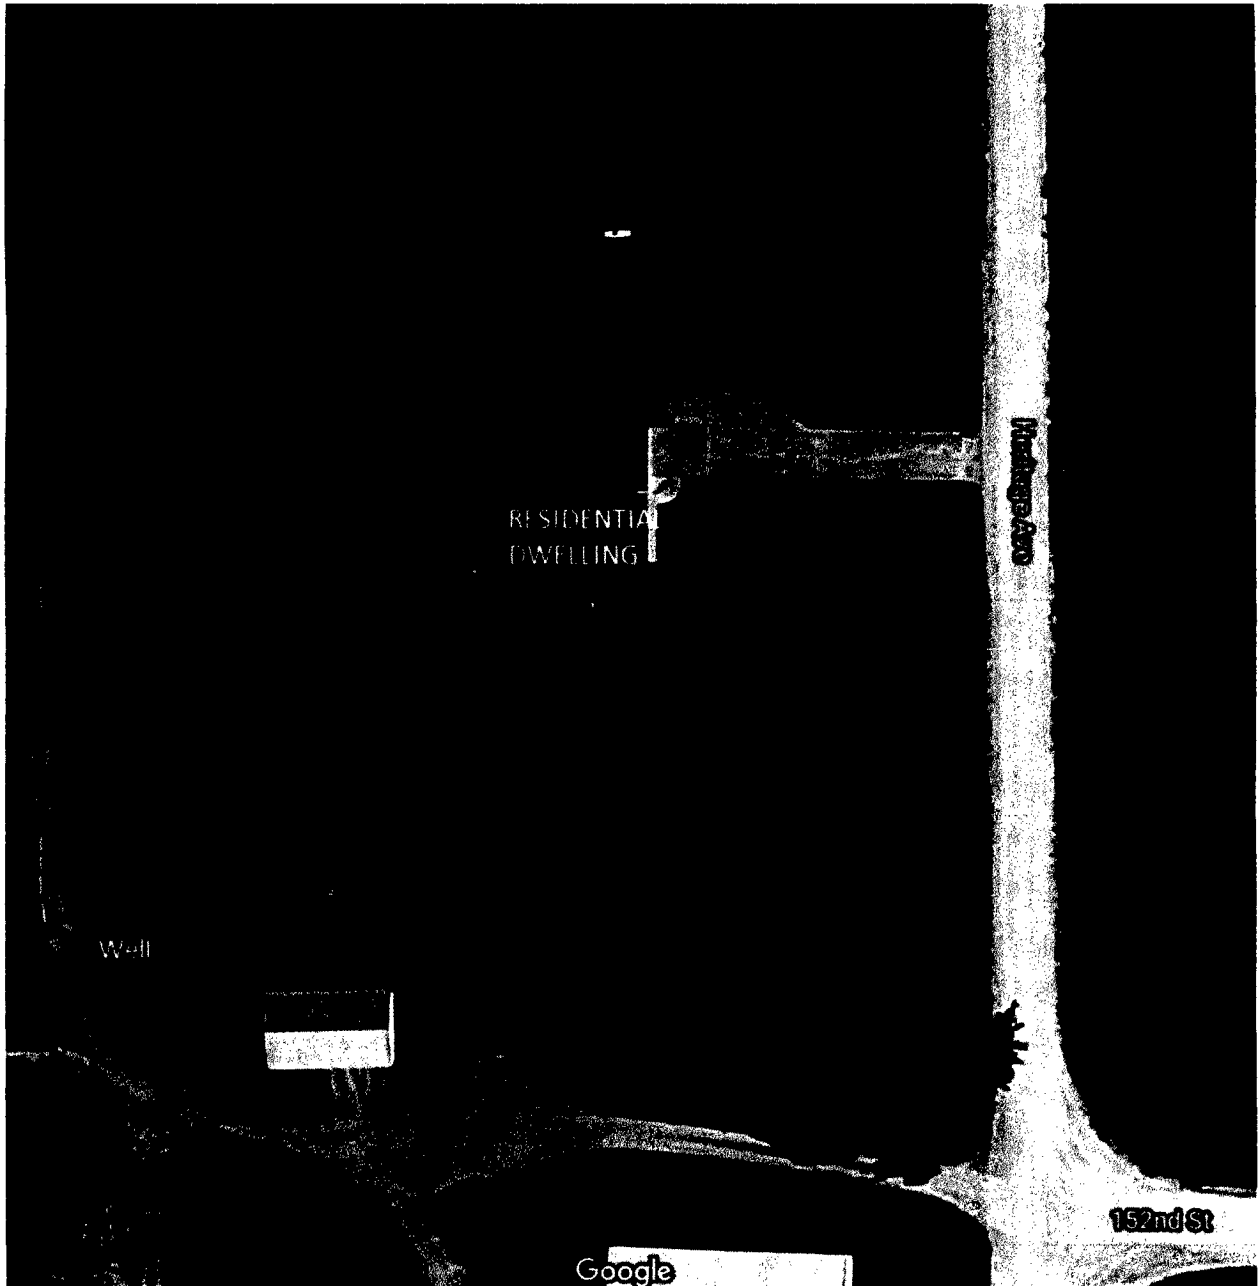



STATE OF IOWA

TERRY E. BRANSTAD, GOVERNOR
KIM REYNOLDS, LT. GOVERNOR

DEPARTMENT OF NATURAL RESOURCES
CHUCK GIPP, DIRECTOR

Time of Transfer Septic Inspection Exemptions

Iowa Code 455B.172(11)

- (1) A transfer made pursuant to a court order, including but not limited to a transfer under Iowa Code chapter 633 or 633A, the execution of a judgment, the foreclosure of a real estate mortgage pursuant to Iowa Code chapter 654, the forfeiture of a real estate contract under Iowa Code chapter 656, a transfer by a trustee in bankruptcy, a transfer by eminent domain, or a transfer resulting from a decree for specific performance.
- (2) A transfer to a mortgagee by a mortgagor or successor in interest who is in default, a transfer by a mortgagee who has acquired real property as a result of a deed in lieu of foreclosure or has acquired real property under Iowa Code chapter 654 or 655A, or a transfer back to a mortgagor exercising a right of first refusal pursuant to Iowa Code section 654.16A.
- (3) A transfer by a fiduciary in the course of the administration of a decedent's estate, guardianship, conservatorship, or trust.
- (4) A transfer between joint tenants or tenants in common.
- (5) A transfer made to a spouse or to a person in the lineal line of consanguinity of a person making the transfer.
- (6) A transfer between spouses resulting from a decree of dissolution of marriage, a decree of legal separation, or a property settlement agreement which is incidental to the decree, including a decree ordered pursuant to Iowa Code chapter 598.
- (7) A transfer in which the transferee intends to demolish or raze the building.
- (8) A transfer of property with a system that was installed not more than two years prior to the date of the transfer.
- (9) A deed arising from a partition proceeding.
- (10) A tax sale deed issued by the county treasurer.
- (11) A transfer for which consideration is \$500 or less.
- (12) A deed between a family corporation, partnership, limited partnership, limited liability partnership, or limited liability company as defined in Iowa Code section 428A.2, subsection 15, and its stockholders, partners, or members for the purpose of transferring real property in an incorporation or a corporate dissolution or in the organization or dissolution of a partnership, limited partnership, limited liability partnership, or limited liability company under the laws of this state, where the deed is given for no actual consideration other than for shares or for debt securities of the family corporation, partnership, limited partnership, limited liability partnership, or limited liability company.