


PREPARED BY: PELDS DESIGN SERVICES - 2323 DIXON STREET, DES MOINES, IOWA 50316 - PH. (515)265-8196

UNITED STATES PUBLIC LAND SURVEY CORNER CERTIFICATE of

 Previously recorded in Book 01 on Page 229 in the office of the County Recorder.

Monument Description & Remarks:

1. W 1/4 Corner found pin With Yellow Cap (Unreadable).
2. SW Corner found "X" Cut in Concrete.
3. New Certificate because old ties were missing.

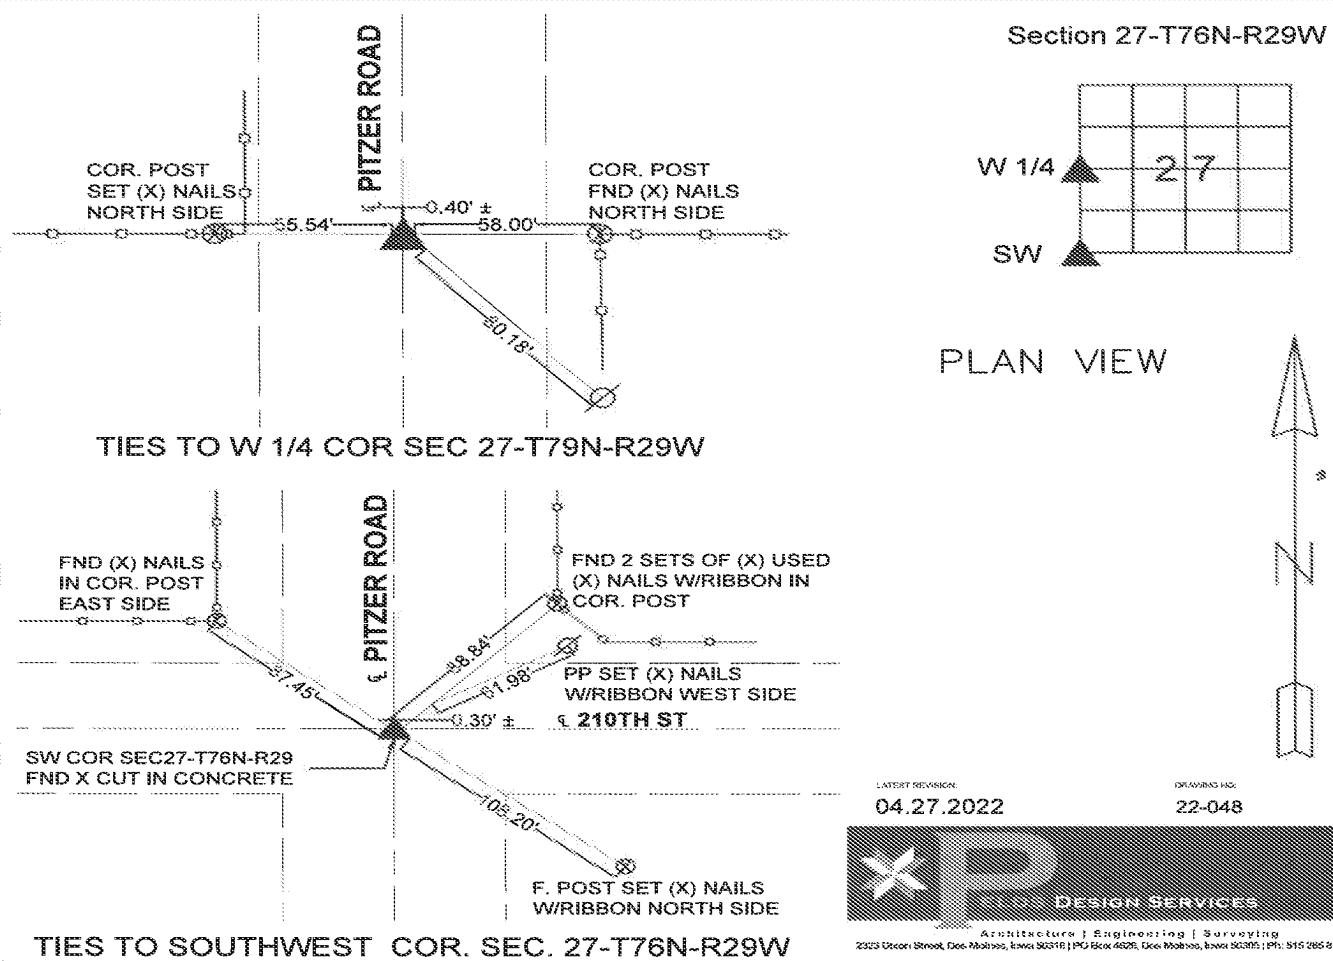

LATEST REVISION: 04.27.2022 DRAWING NO: 22-048

PELDS DESIGN SERVICES
 Architecture | Engineering | Surveying
 2323 Dixon Street, Des Moines, Iowa 50316 | PO Box 4626, Des Moines, Iowa 50305 | PH: 515 265 8196


I HEREBY CERTIFY THAT THIS LAND SURVEYING DOCUMENT WAS PREPARED AND THE RELATED WORK WAS PERFORMED BY ME OR UNDER MY DIRECT PERSONAL SUPERVISION AND THAT I AM A DULY LICENSED PROFESSIONAL LAND SURVEYOR UNDER THE LAWS OF THE STATE OF IOWA.

Voldebars L. Pelds 4/27/2022

VOLDEMARS LEO PELDS, P.L.S., LIC. NO. 18842 DATE

MY LICENSE RENEWAL DATE IS DECEMBER 31, 2023

ADDITIONAL PAGES OR SHEETS COVERED BY THIS SEAL (NONE UNLESS INDICATED HERE):

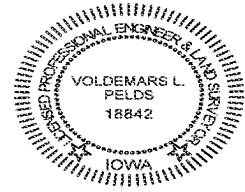

Corner	Section	Twp	Range
W 1/4 Corner	27	76	29
SW Corner	27	76	29
E 1/4 Corner	28	76	29
SE Corner	28	76	29
NW Corner	34	76	29