



Document 2022 1480

Book 2022 Page 1480 Type 06 043 Pages 1  
Date 5/19/2022 Time 2:50:47PM  
Rec Amt \$.00

INDX  
ANNO  
SCAN  
CHEK

LISA SMITH, COUNTY RECORDER  
MADISON COUNTY IOWA

Prepared By: Michael James Hackett, Madison County Engineer's Office, 1105 E. Court Ave., Winterset, Ia. 50273, Tel. (515) 462-1136

UNITED STATES PUBLIC LAND SURVEY CORNER CERTIFICATE  
OF


Land Survey Monuments situated in Section 10, Township 75 N, Range 27 W, of the Fifth Principal Meridian, Madison County, Iowa.  
Previously recorded in Book 2, Page 15 in County Recorder's Office.  
(book, page, document number, etc.)

(Show reason for preparing this certificate, the evidence and detailed procedures used in establishing the corner positions and monumentation found or placed.)

Monument Description and Remarks: Previous monument disturbed during Madison County project  
FM-C061(117)--55-61 A.C.C. pavement resurfacing and reconstruction. Set 2"x 1/4" MAG nail on surface of A.C.C.  
pavement. The corner position was established by using existing found monument, existing ties, and reestablished  
ties during the resurfacing and reconstruction. Accepted position.


PLAN VIEW

(Show a minimum of three reference ties to durable physical objects, relevant monuments and physical conditions that will enable recovery of the corner.)

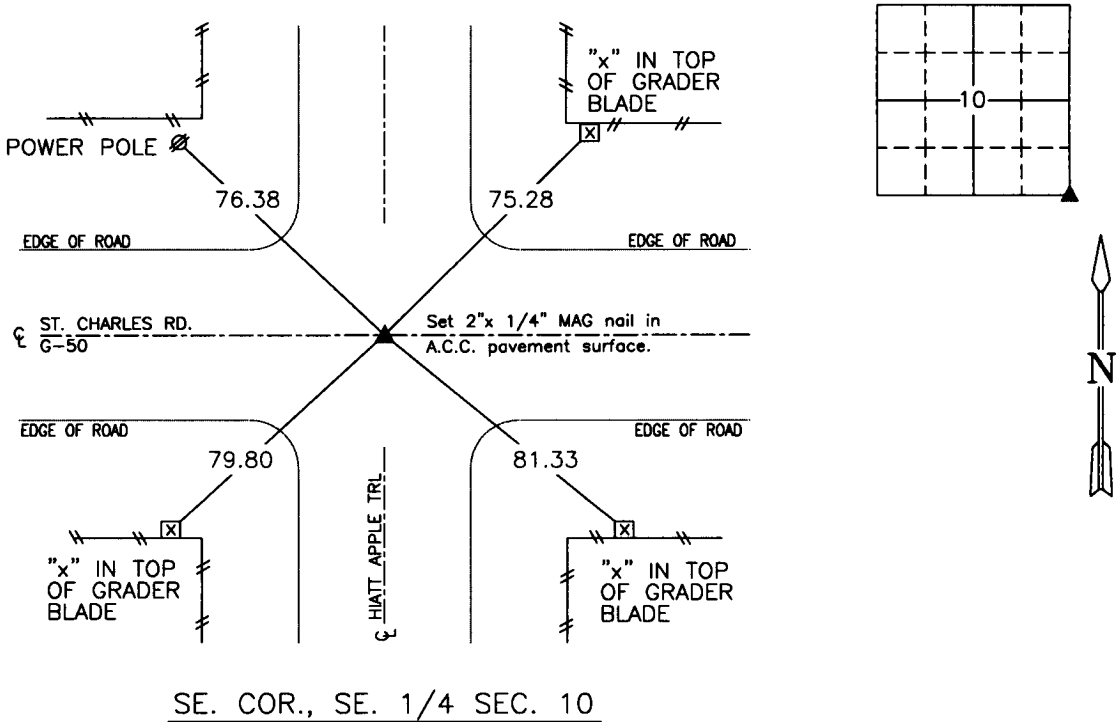

SE. COR., SE. 1/4 SEC. 10

NOTE: ALL TIES TO "X" NAILS UNLESS NOTED

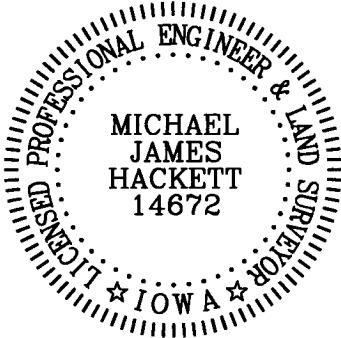

I hereby certify that this land surveying document was prepared and the related survey work was performed by me or under my direct personal supervision and that I am a duly Licensed Land Surveyor under the laws of the State of Iowa.

Signed Michael James Hackett Date 4/6/2022  
Michael James Hackett

Iowa license number 14672.  
My license renewal date is 12/31/2022.  
Pages covered by this seal: 1.

FM-C061(117)--55-61  
J-17