



Document 2022 1481

Book 2022 Page 1481 Type 06 043 Pages 1

Date 5/19/2022 Time 2:50:48PM

Rec Amt \$.00

INDX
ANNO
SCAN

LISA SMITH, COUNTY RECORDER
MADISON COUNTY IOWA

CHEK

Prepared By: Michael James Hackett, Madison County Engineer's Office, 1105 E. Court Ave., Winterset, Ia. 50273, Tel. (515) 462-1136

UNITED STATES PUBLIC LAND SURVEY CORNER CERTIFICATE OF


Land Survey Monuments situated in Section 10, Township 75 N, Range 27 W, of the Fifth Principal Meridian, Madison County, Iowa.
Previously recorded in Book 2, Page 15 in County Recorder's Office.
(book, page, document number, etc.)

(Show reason for preparing this certificate, the evidence and detailed procedures used in establishing the corner positions and monumentation found or placed.)


Monument Description and Remarks: Previous monument disturbed during Madison County project
FM-C061(117)--55-61 A.C.C. pavement resurfacing and reconstruction. Set 2"x 1/4" MAG nail on surface of A.C.C.
pavement. The corner position was established by using existing found monument, existing ties, and reestablished
ties during the resurfacing and reconstruction. Accepted position.

PLAN VIEW

(Show a minimum of three reference ties to durable physical objects, relevant monuments and physical conditions that will enable recovery of the corner.)

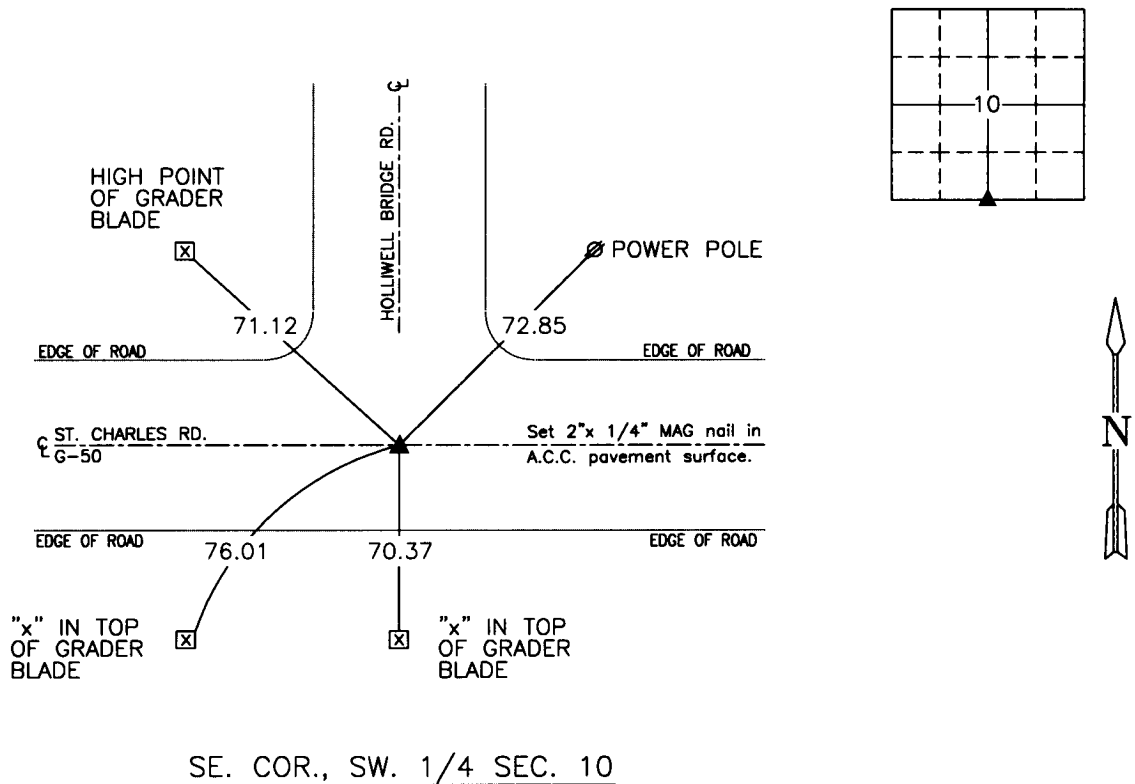

NOTE: ALL TIES TO "X" NAILS UNLESS NOTED

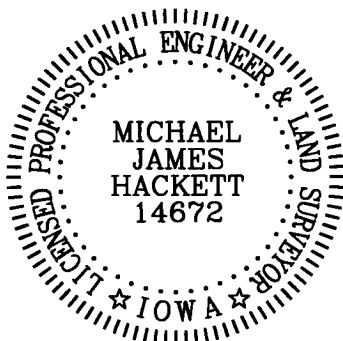

I hereby certify that this land surveying document was prepared and the related survey work was performed by me or under my direct personal supervision and that I am a duly Licensed Land Surveyor under the laws of the State of Iowa.

Signed

Michael James Hackett

Date

4/6/2022

Iowa license number 14672.

My license renewal date is 12/31/2022.

Pages covered by this seal: 1.

FM-C061(117)--55-61
J-15