



Document 2022 1489

Book 2022 Page 1489 Type 06 043 Pages 1  
Date 5/19/2022 Time 2:50:56PM  
Rec Amt \$ .00

INDX  
ANNO  
SCAN

LISA SMITH, COUNTY RECORDER  
MADISON COUNTY IOWA

CHEK

Prepared By: Michael James Hackett, Madison County Engineer's Office, 1105 E. Court Ave., Winterset, Ia. 50273, Tel. (515) 462-1136

# UNITED STATES PUBLIC LAND SURVEY CORNER CERTIFICATE OF


Land Survey Monuments situated in Section 23, Township 75 N, Range 26 W, of the Fifth Principal Meridian, Madison County, Iowa.  
Previously recorded in Book 1, Page 676 in County Recorder's Office.  
(book, page, document number, etc.)

(Show reason for preparing this certificate, the evidence and detailed procedures used in establishing the corner positions and monumentation found or placed.)

Monument Description and Remarks: Previous monument disturbed during Madison County project FM-C061(117)--55-61 A.C.C. pavement resurfacing and reconstruction. Set 2"x 1/4" MAG nail in surface of A.C.C. pavement. The corner position was established by using existing found monument, existing ties, and reestablished ties during the resurfacing and reconstruction. Accepted position.


## PLAN VIEW

(Show a minimum of three reference ties to durable physical objects, relevant monuments and physical conditions that will enable recovery of the corner.)

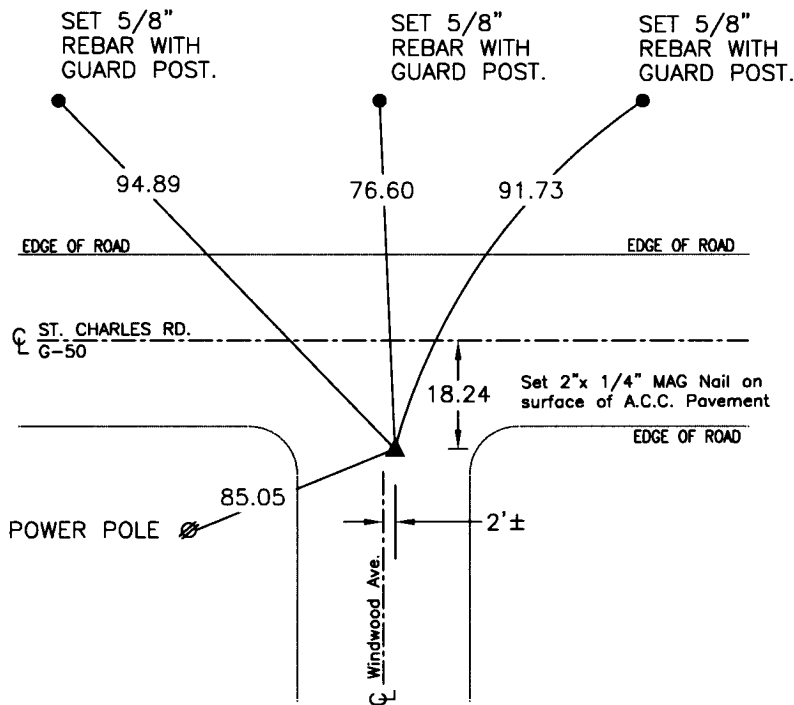

SW. COR., NW. 1/4 NE. 1/4 SEC. 23

NOTE: ALL TIES TO "X" NAILS UNLESS NOTED

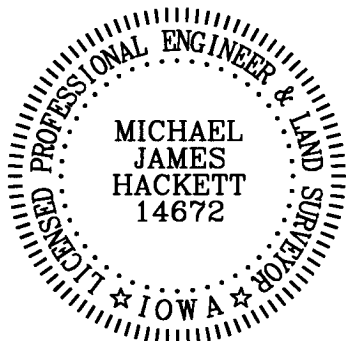

I hereby certify that this land surveying document was prepared and the related survey work was performed by me or under my direct personal supervision and that I am a duly Licensed Land Surveyor under the laws of the State of Iowa.

Signed Michael James Hackett Date 4/6/2022  
Michael James Hackett

Iowa license number 14672.  
My license renewal date is 12/31/2022.  
Pages covered by this seal: 1.

FM-C061(117)--55-61  
0-19