

INDEX LEGEND

Location: Barker's 2nd Addition to Macksburg
 Requestor: Rhonda Dean
 Proprietor: Rhonda Dean
 Project: 22057 Date of Survey: 11/21/2022
 Surveyor Co: Boldman Surveying & Consulting
 Prepared by/Return to: Craig S. Boldman
 521 West Green Street, Winterset, Ia 50273
 Phone/fax: 515-462-9242


BK: 2022 PG: 3407
 Recorded: 11/23/2022 at 9:11:16.0 AM
 Pages 1
 County Recording Fee: \$7.00
 Iowa E-Filing Fee: \$3.13
 Combined Fee: \$10.13
 Revenue Tax:
LISA SMITH RECORDER
 Madison County, Iowa

BOUNDARY RETRACEMENT SURVEY (from Quit Claim Deed filed in Book 2015 Page 2397)


Lots Nine (9) and Ten (10) in Block Seven (7) of Barker's Second Addition to the Original Town of Macksburg, Madison County, Iowa



NW CORNER SECTION 15-74-25

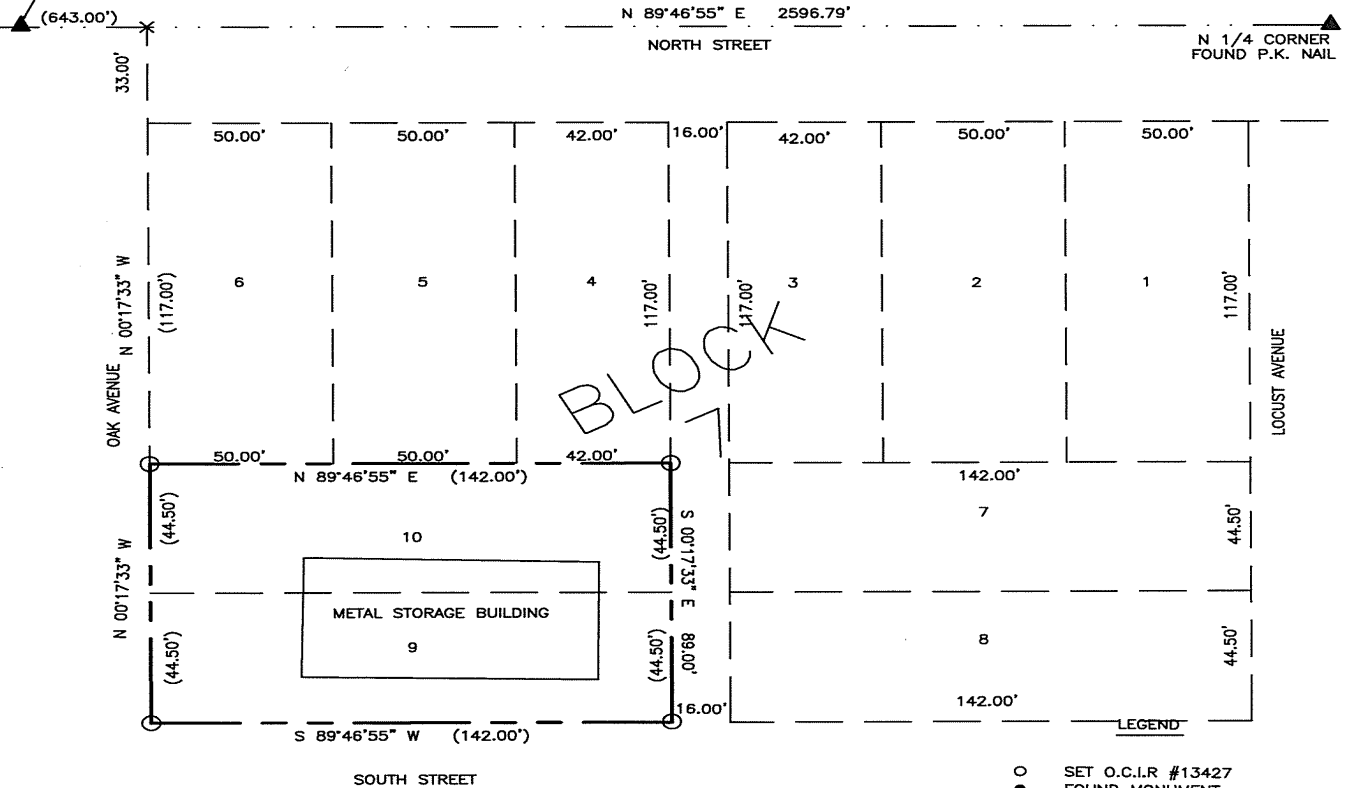

- LEGEND
- SET O.C.I.R. #13427
 - FOUND MONUMENT
 - × NOTHING SET
 - △ SET PLSS CORNER
 - ▲ FOUND PLSS CORNER
 - (XXX) RECORD PLAT OR DEED
 - Y.C.I.R. YELLOW CAPPED IRON ROD
 - O.C.I.R. ORANGE CAPPED IRON ROD

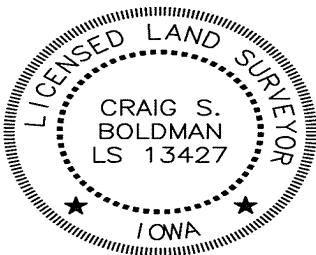

I hereby certify that this land surveying document was prepared and the related survey work was performed by me or under my direct supervision and that I am a duly licensed Land Surveyor under the laws of the State of Iowa

Signature: *Craig S. Boldman* Date: *11/23/22*

Name Craig S. Boldman P.L.S No. 13427

Renewal date is December 31, 2022

Pages or sheets covered by this seal *All*