



# INDEX LEGEND

Location:: Barker's 2nd Addition to Macksburg  
 Requestor: John Timothy Waddingham  
 Proprietor: John Timothy Waddingham  
 Project: 22061 Date of Survey: 12/9/22  
 Surveyor Co: Boldman Surveying Consultants  
 Prepared by/Return to: Craig S.Boldman  
 521 West Green Street, Winterset, Ia 50273  
 Phone/fax: 515-462-9242

BK: 2022 PG: 3746  
 Recorded: 12/29/2022 at 9:12:00.0 AM  
 Pages 1  
 County Recording Fee: \$7.00  
 Iowa E-Filing Fee: \$3.13  
 Combined Fee: \$10.13  
 Revenue Tax:  
 LISA SMITH RECORDER  
 Madison County, Iowa

## BOUNDARY RETRACEMENT SURVEY from Book 60 Page 229 and Doc# 2018-3975

Lot Thirteen (13), Block Four (4) Barkers Addition No.2 to the City of Macksburg; and Lot Fourteen (14) in Block Four (4) of Barkers Addition to the City of Macksburg, Madison County, Iowa and Lot One (1); West Half (1.2) of Lots Two (2), Three (3), Four (4) and Five (5); West Sixty (60) feet of Lots Six (6), Seven (7), Eight (8), and Nine (9); Lot Fifteen (15), all in Block Four (4) of Barker's Second Addition to Macksburg, Madison County, Iowa. EXCEPT The East Fifty-five feet of Lot One (1) in Block Four (4) of Barker's 2nd Addition to the Town of Macksburg, Madison County, Iowa.

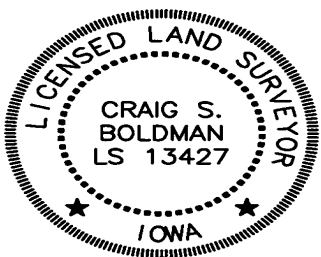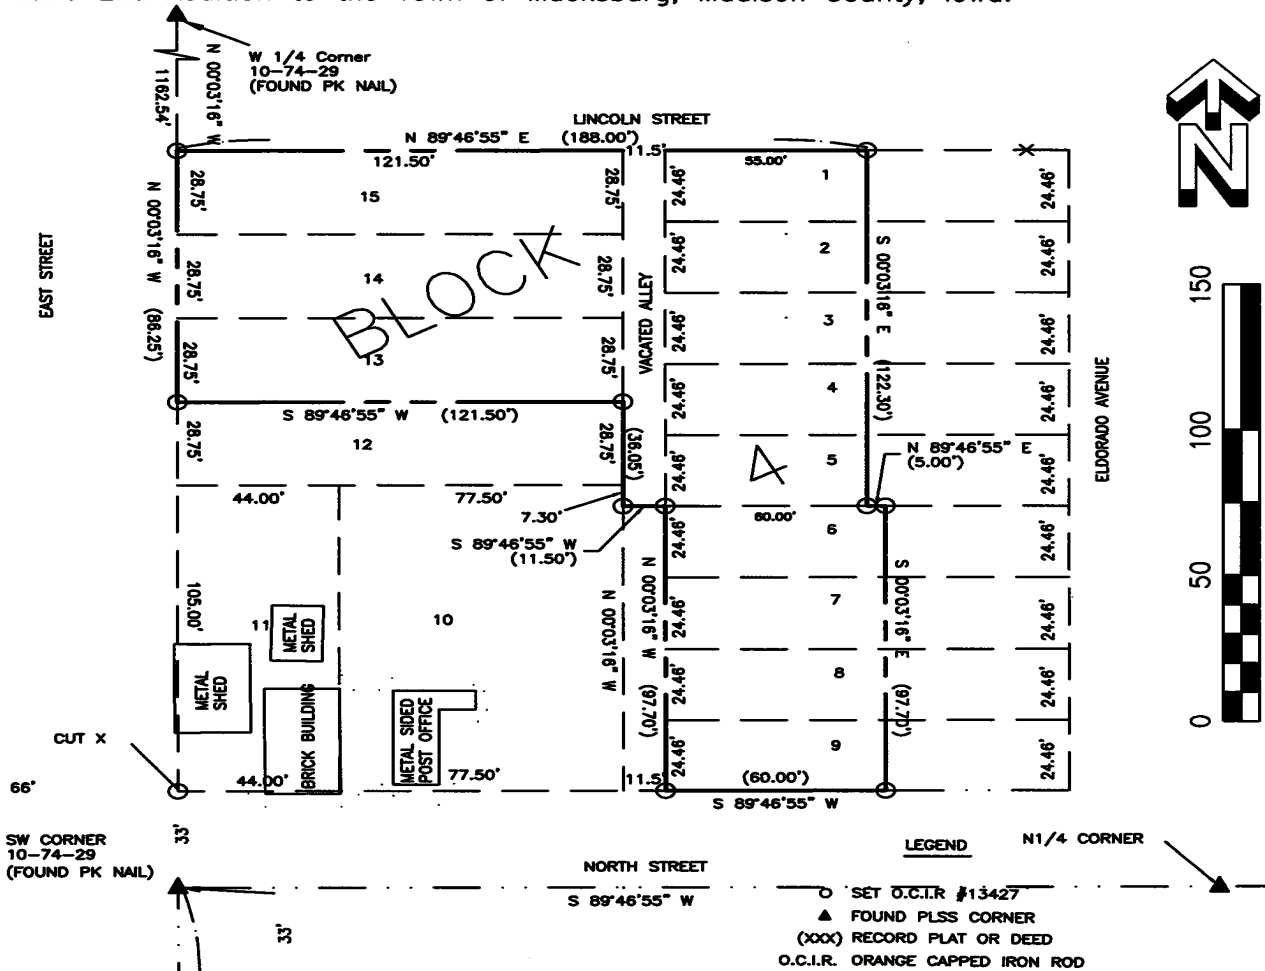

I hereby certify that this land surveying document was prepared and the related survey work was performed by me or under my direct supervision and that I am a duly licensed Land Surveyor under the laws of the State of Iowa

Signature *Craig S. Boldman* Date 12/29/22

Name Craig S. Boldman P.L.S No. 13427

Renewal date is December 31, 2022

Pages or sheets covered by this seal A11