

COUNTY: MADISON
SITE ADDRESS: 1890 HOGBACK BRIDGE RD
CITY: WINTERSET
PARCEL: "D"
ALIQUOT: NW1/4 SW1/4, NE1/4 SW1/4, SE1/4 SW1/4
SECTION: 14 TOWNSHIP: 76 RANGE: 28
PROPRIETOR: PAUL F. MARSHALL & EMILY J. MARSHALL
REQUESTED BY: NEW CENTURY BANK
SURVEYOR NAME: Vincent E. Piagentini



Document 2022 815

Book 2022 Page 815 Type 06 026 Pages 1
Date 3/21/2022 Time 10:13:54AM
Rec Amt \$7.00

INDX
ANNO
SCAN
CHEK

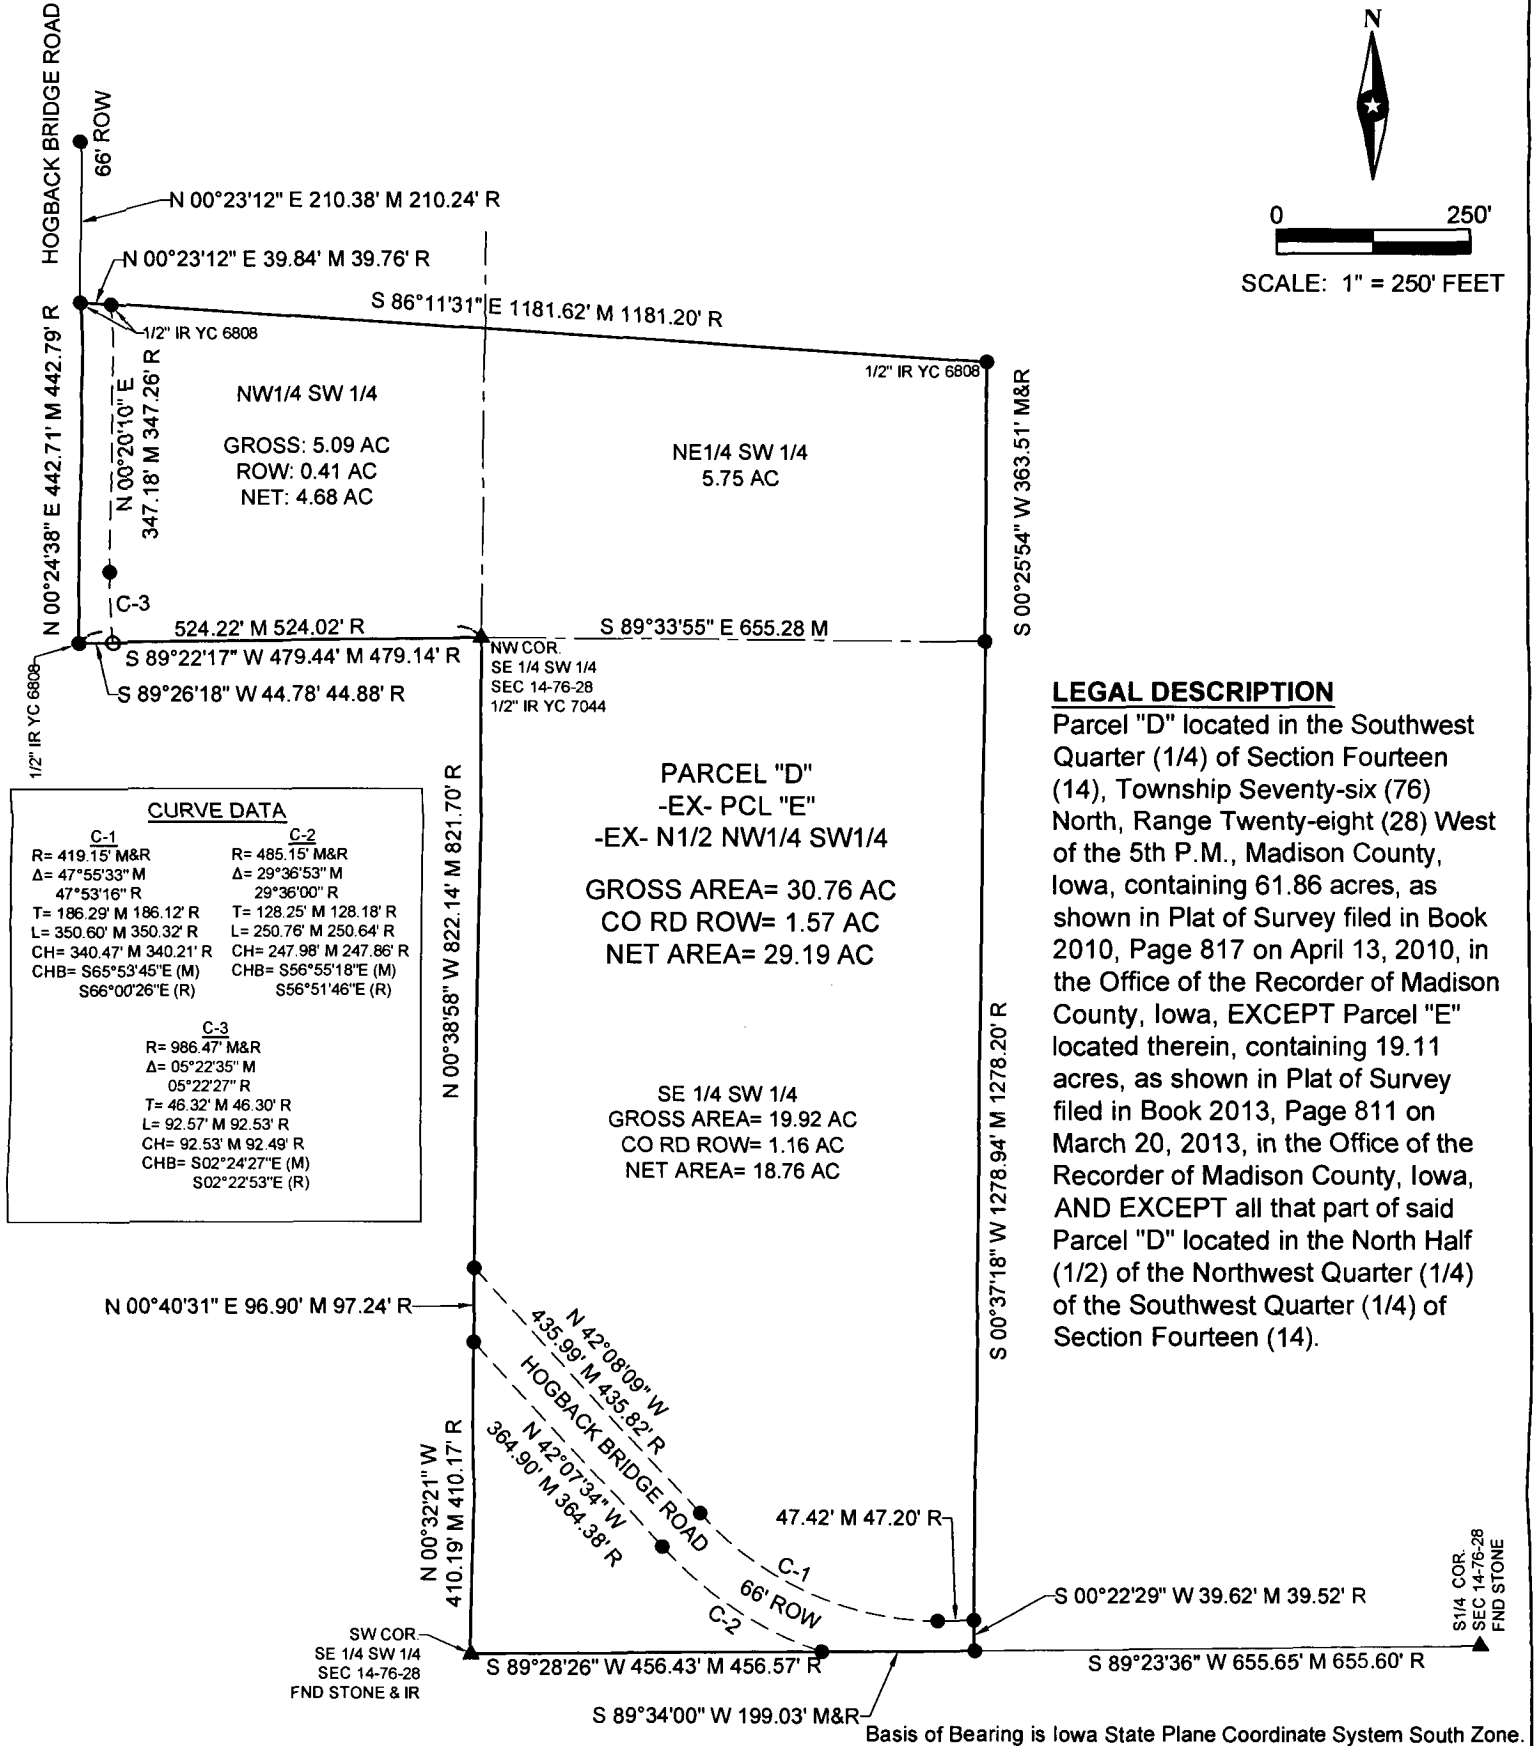
LISA SMITH, COUNTY RECORDER
MADISON COUNTY IOWA

ABACI CONSULTING, INC.**CIVIL ENGINEERING - LAND SURVEYING**

3000 SE Grimes Blvd, Ste 800, GRIMES, IOWA 50111, PH. (515)986-5048

THIS SPACE RESERVED FOR RECORDER'S OFFICE USE ONLY

PREPARED BY & RETURN TO: ABACI CONSULTING INC, 3000 SE Grimes Blvd Ste 800, GRIMES, IA 50111, PH(515)986-5048

BOUNDARY RETRACEMENT SURVEY

FIELD WORK DATE: 03/08/2022 DRAWING DATE: 03/10/2022 DRAFTER: MB JOB NUMBER: 22025

I HEREBY CERTIFY THAT THIS SURVEYING DOCUMENT WAS PREPARED AND THE RELATED WORK WAS PERFORMED BY ME OR UNDER MY DIRECT PERSONAL SUPERVISION AND THAT I AM A DULY LICENSED PROFESSIONAL LAND SURVEYOR UNDER THE LAWS OF THE STATE OF IOWA.

SIGNATURE: *Vincent E. Piagentini* DATE: 3/16/22
VINCENT E. PIAGENTINI

PRINTED OR TYPED NAME:
IOWA LIC. NO. 15982
MY LICENSE RENEWAL DATE IS DECEMBER 31, 2022.

THIS SHEET ONLY

PAGES COVERED BY THIS SEAL:

**LEGEND OF SYMBOLS & ABBREVIATIONS**

R RECORDED DISTANCE OC ORANGE CAP
M MEASURED DISTANCE IR IRON PIPE
C CALCULATED DISTANCE IP IRON ROD
● FOUND 1/2" IR YC 7995 UNLESS NOTED
○ SET 1/2" IR YC 15982 UNLESS NOTED
▲ SECTION CORNER FOUND
△ SECTION CORNER SET 1/2" IR YC 15982 UNLESS NOTED
POB POINT OF BEGINNING
POC POINT OF COMMENCEMENT
YC YELLOW CAP