

BK: 2022 PG: 1551
Recorded: 5/25/2022 at 2:17:24.0 PM
Pages 3
County Recording Fee: \$0.00
Iowa E-Filing Fee: \$0.00
Combined Fee: \$0.00
Revenue Tax:
LISA SMITH RECORDER
Madison County, Iowa

**REAL ESTATE TRANSFER - GROUNDWATER HAZARD STATEMENT
TO BE COMPLETED BY TRANSFEROR**

TRANSFEROR:

Name: Dennis Ray Faust and Tracy Lynn Faust
Address: 1128 West Jefferson Street, Winterset, IA 50273

TRANSFeree:

Name: Jessica Conaway and Matthew Conaway
Address: 1154 180th Street, Dexter, IA 50070

Address of Property Transferred:
1154 180th Street, Dexter, Iowa 50070

Legal Description of Property: (Attach if necessary)

A parcel of land described as the West 293.9 feet of the North 173 feet of the Northwest Quarter (¼) of the Northeast Quarter (¼) of Section Seventeen (17) in Township Seventy-six (76) North, Range Twenty-nine (29) West of the 5th P.M., Madison County, Iowa, containing 1.1672 Acres including 0.2227 Acres of County Road Right of Way

1. Wells (check one)

- There are no known wells situated on this property.
 There is a well or wells situated on this property. The type(s), location(s) and legal status are stated below or set forth on an attached separate sheet, as necessary.

2. Solid Waste Disposal (check one)

- There is no known solid waste disposal site on this property.
 There is a solid waste disposal site on this property and information related thereto is provided in Attachment #1, attached to this document.

3. Hazardous Wastes (check one)

- There is no known hazardous waste on this property.
 There is hazardous waste on this property and information related thereto is provided in Attachment #1, attached to this document.

4. Underground Storage Tanks (check one)

- There are no known underground storage tanks on this property. (Note exclusions such as small farm and residential motor fuel tanks, most heating oil tanks, cisterns and septic tanks, in instructions.)
 There is an underground storage tank on this property. The type(s), size(s) and any known substance(s) contained are listed below or on an attached separate sheet, as necessary.

FILE WITH RECORDER

DNR form 542-0960 (July 18, 2012)

5. Private Burial Site (check one)

- There are no known private burial sites on this property.
- There is a private burial site on this property. The location(s) of the site(s) and known identifying information of the decedent(s) is stated below or on an attached separate sheet, as necessary.

6. Private Sewage Disposal System (check one)

- All buildings on this property are served by a public or semi-public sewage disposal system.
- This transaction does not involve the transfer of any building which has or is required by law to have a sewage disposal system.
- There is a building served by private sewage disposal system on this property or a building without any lawful sewage disposal system. A certified inspector's report is attached which documents the condition of the private sewage disposal system and whether any modifications are required to conform to standards adopted by the Department of Natural Resources. A certified inspection report must be accompanied by this form when recording.
- There is a building served by private sewage disposal system on this property. Weather or other temporary physical conditions prevent the certified inspection of the private sewage disposal system from being conducted. The buyer has executed a binding acknowledgment with the county board of health to conduct a certified inspection of the private sewage disposal system at the earliest practicable time and to be responsible for any required modifications to the private sewage disposal system as identified by the certified inspection. A copy of the binding acknowledgment is attached to this form.
- There is a building served by private sewage disposal system on this property. The buyer has executed a binding acknowledgment with the county board of health to install a new private sewage disposal system on this property within an agreed upon time period. A copy of the binding acknowledgment is provided with this form.
- There is a building served by private sewage disposal system on this property. The building to which the sewage disposal system is connected will be demolished without being occupied. The buyer has executed a binding acknowledgment with the county board of health to demolish the building within an agreed upon time period. A copy of the binding acknowledgment is provided with this form. [Exemption #9]
- This property is exempt from the private sewage disposal inspection requirements pursuant to the following exemption [Note: for exemption #9 use prior check box]: Section 455B.172(11)(a)(5).
- The private sewage disposal system has been installed within the past two years pursuant to permit number _____.

Information required by statements checked above should be provided here or on separate sheets attached hereto:

**I HEREBY DECLARE THAT I HAVE REVIEWED THE INSTRUCTIONS
FOR THIS FORM AND THAT THE INFORMATION STATED
ABOVE IS TRUE AND CORRECT.**

Signature: _____


Dennis R Faust
(Transferor)
Tracy L Faust


Telephone No.: (515) 979-5961

Overview



Legend

- Parcels
- Townships
- Sections
- City Limits
-  Road Centerlines

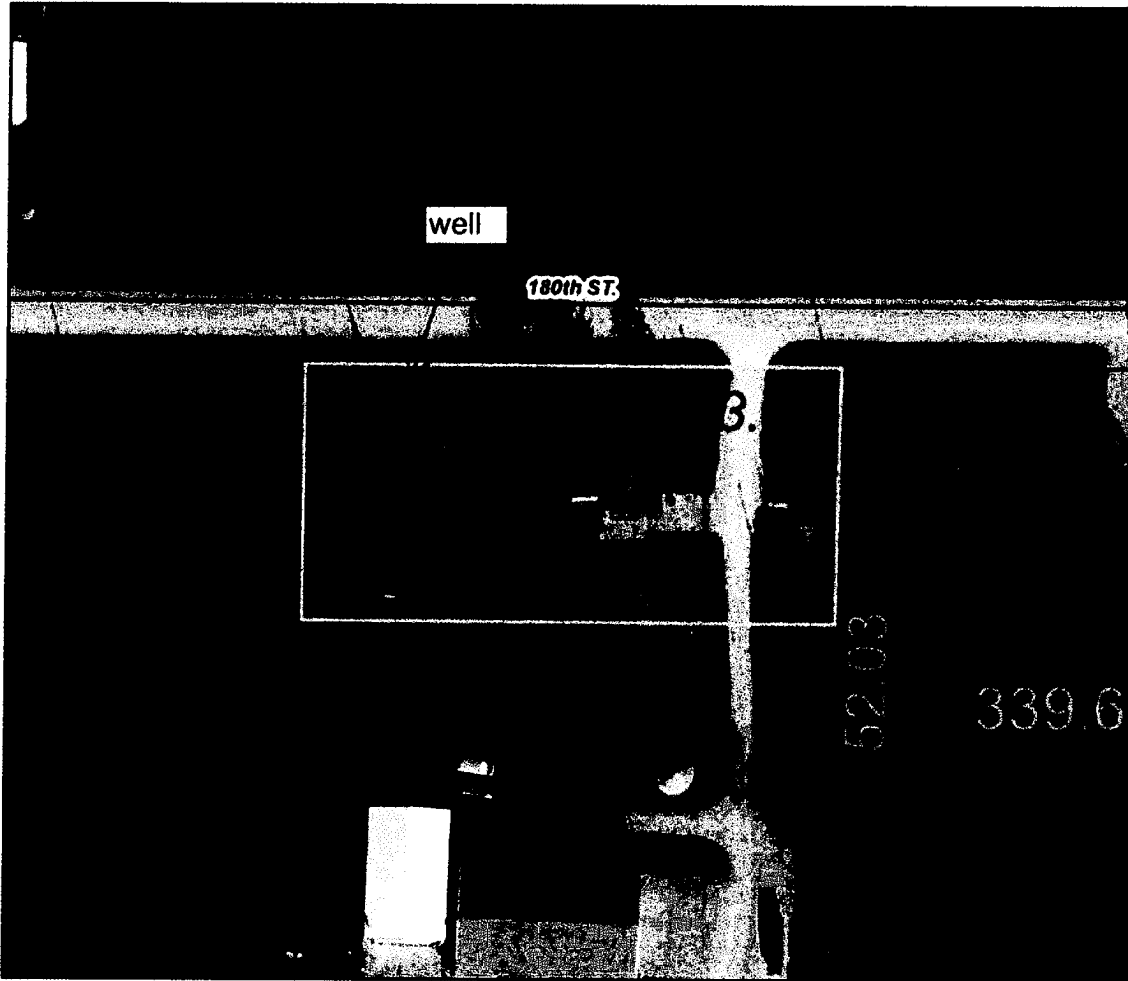

Parcel ID	290051724020000	Alternate ID	n/a	Owner Address	Faust, Dennis Ray & Tracy Lynn
Sec/Twp/Rng	17-76-29	Class	A		1154 180Th St
Property Address	1154 180TH ST	Acreage	1.17		Dexter, IA 50070-
	DEXTER				
District	JACKSON WINTERSET WFD				
Brief Tax Description	1.17A NW COR NW NE				
	(Note: Not to be used on legal documents)				

Date created: 5/25/2022
 Last Data Uploaded: 5/24/2022 9:50:17 PM

Developed by  **Schneider**
 GEOSPATIAL