

INDEX LEGEND

LEGAL DESCRIPTION: Parcel "D"
 SE-SE Section 18-77-28
 SURVEY DATE: 7/05/23
 COUNTY: Madison TOWNSHIP: Madison
 SITE ADDRESS: SE-SE Section 18-77-28
 OWNERS: Annette Howell
 REQUESTED BY: Peter Kasap
 SURVEYOR: WILLIAM J. FOX, 802 NORTH STREET
 SHELBY, IA. 51570 712-307-0253




Document 2023 1597

Book 2023 Page 1597 Type 06 026 Pages 1
 Date 7/12/2023 Time 3:10:20PM
 Rec Amt \$7.00


INDX
 ANNO
 SCAN

BRANDY MACUMBER, COUNTY RECORDER
 MADISON COUNTY IOWA

CHEK

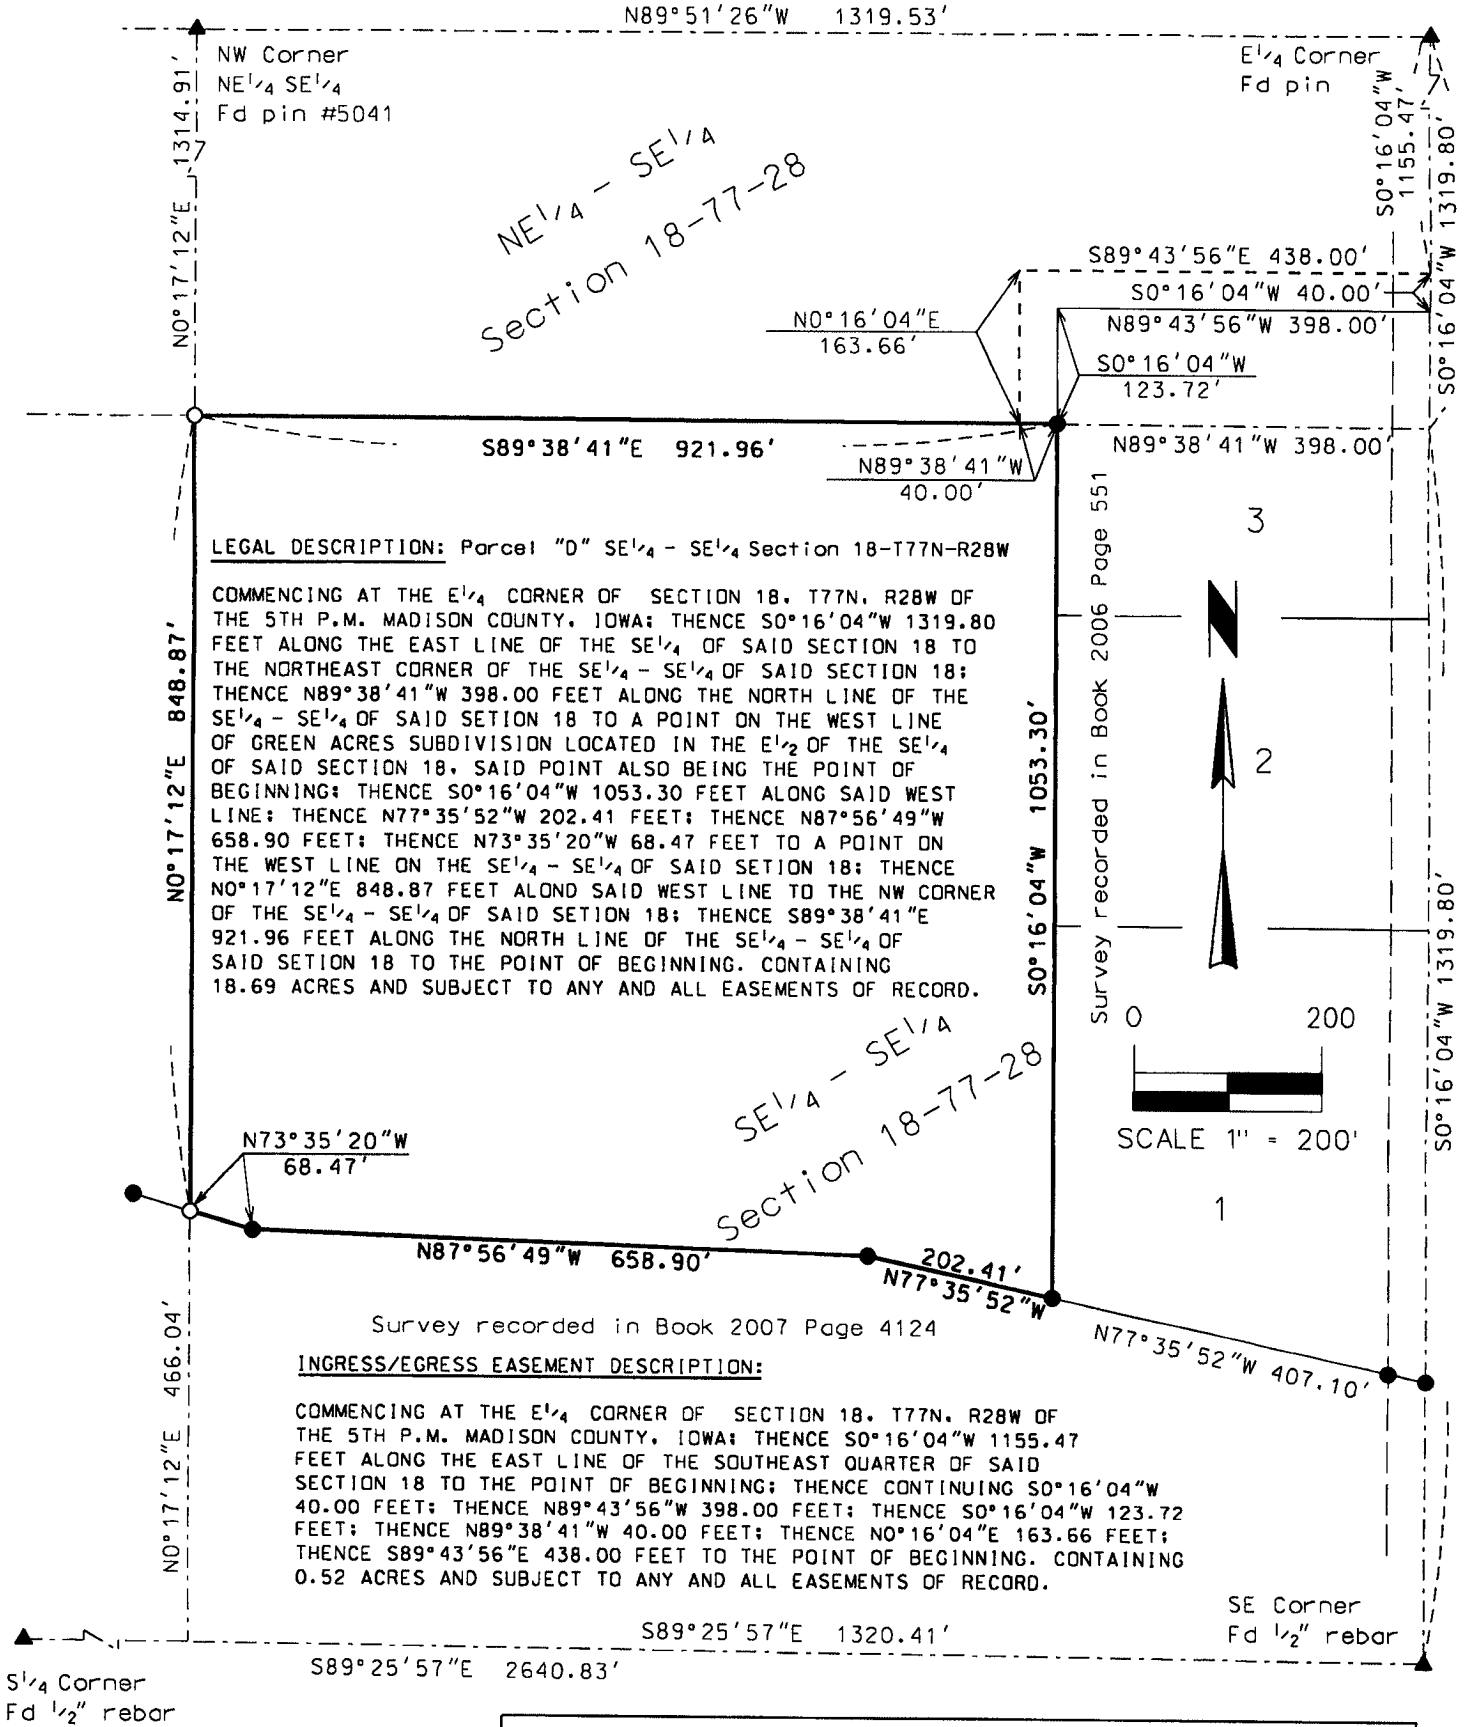

<u>LEGEND</u>	
SECTION CORNER	▲
FOUND CORNER CAP #12534	●
SET 1/2" REBAR CAP #15482	○
M = MEASURED DISTANCE	
P = PLATTED DISTANCE	

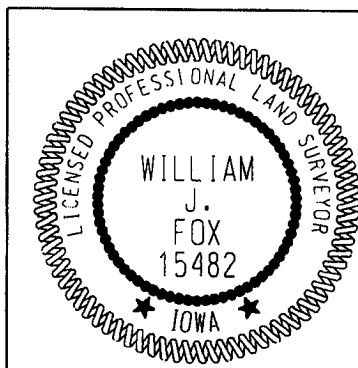

I hereby certify that this land surveying document was prepared and the related surveying work was performed by me or under my direct supervision and that I am a duly licensed Land Surveyor under the laws of the State of Iowa.

William J. Fox 7-11-23
 William J. Fox, P.L.S. Date
 License Number 15482
 My License Renewal Date is December 31, 2023
 Pages or sheets covered by this seal: