

**INDEX LEGEND**


LEGAL DESCRIPTION: Parcel "D"  
 SE-SE Section 18-77-28  
 SURVEY DATE: 7/05/23  
 COUNTY: Madison TOWNSHIP: Madison  
 SITE ADDRESS: SE-SE Section 18-77-28  
 OWNERS: Annette Howell  
 REQUESTED BY: Peter Kasap  
 SURVEYOR: WILLIAM J. FOX, 802 NORTH STREET  
 SHELBY, IA. 51570 712-307-0253



Document 2023 1675  
 Book 2023 Page 1675 Type 06 026 Pages 1  
 Date 7/19/2023 Time 1:22:24PM  
 Rec Amt \$7.00


INDX  
 ANNO  
 SCAN

BRANDY MACUMBER, COUNTY RECORDER  
 MADISON COUNTY IOWA

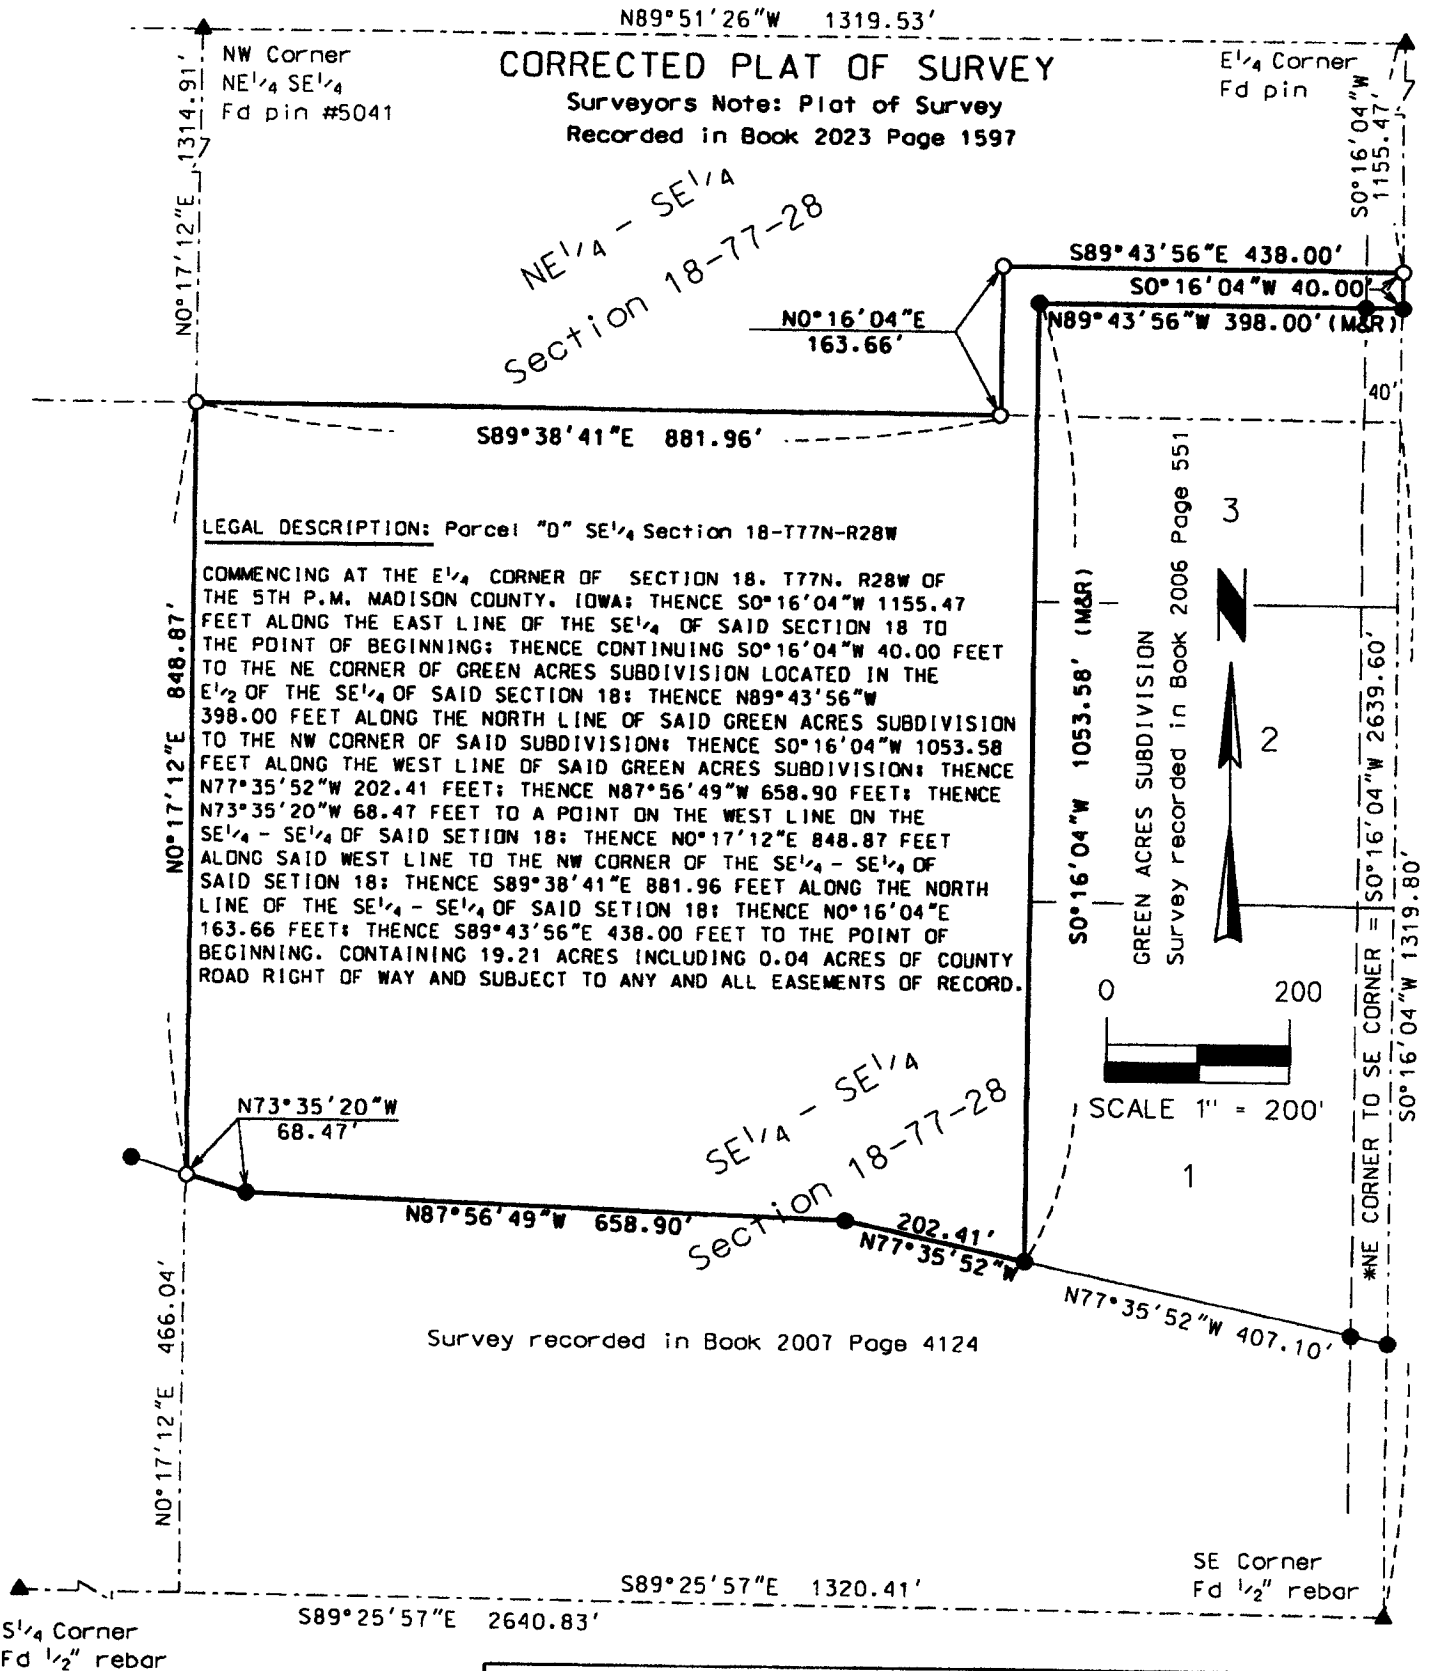

**LEGEND**

SECTION CORNER	▲
FOUND CORNER CAP #12534	●
SET 1/2" REBAR DISTANCE	○
M = MEASURED DISTANCE	
P = PLATTED DISTANCE	

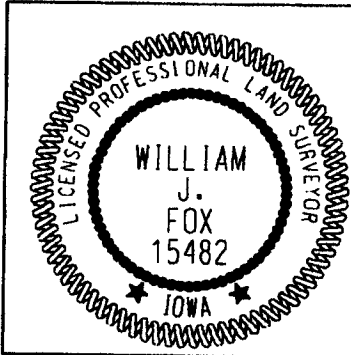

I hereby certify that this land surveying document was prepared and the related surveying work was performed by me or under my direct supervision and that I am a duly licensed Land Surveyor under the laws of the State of Iowa.

*William J. Fox* 7-17-23  
 William J. Fox, P.L.S. Date  
 License Number 15482  
 My License Renewal Date is December 31, 2023  
 Pages or sheets covered by this seal: