


# INDEX LEGEND


Location:: Lot:5 Block:18 Pitzer & Knights's Add.  
 Requestor: Heather Tomlinson  
 Proprietor: Heather Tomlinson  
 Project: 23023 Date of Survey: 5/2/2023  
 Surveyor Co: Boldman Surveying & Consulting  
 Prepared by/Return to: Craig S.Boldman  
 521 West Green Street, Winterset, Ia 50273  
 Phone/fax: 515-462-9242

BK: 2023 PG: 972  
 Recorded: 5/8/2023 at 12:00:24.0 PM  
 Pages 1  
 County Recording Fee: \$7.00  
 Iowa E-Filing Fee: \$3.13  
 Combined Fee: \$10.13  
 Revenue Tax:  
 BRANDY L. MACUMBER, RECORDER  
 Madison County, Iowa

BOUNDARY RETRACEMENT SURVEY (from Warranty Deed Book 2020 Page 2347)  
 Lot Five (5) in Block Eighteen (18) of Pitzer & Knight's Addition to the Town of  
 Winterset, Madison County, Iowa

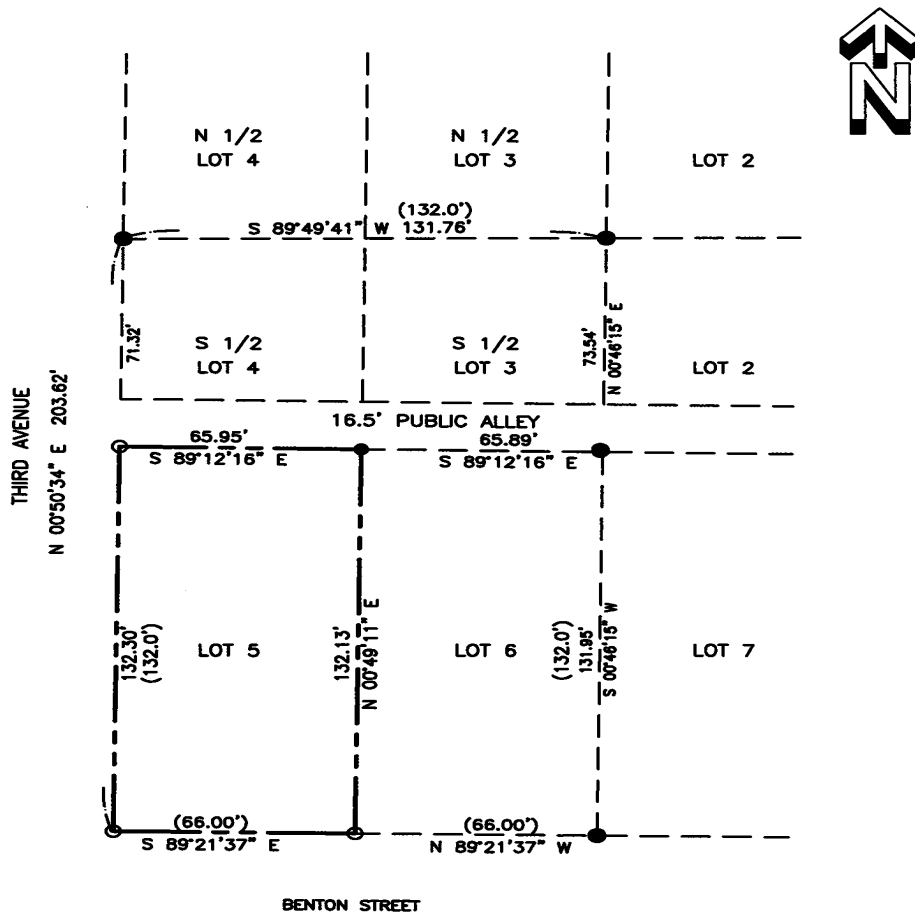

**LEGEND**  
 (XXX) RECORD OR DEED DIMENSION  
 ● FOUND 1/2" IRON ROD w/ YELLOW PLASTIC CAP #5041  
 ○ SET 1/2" IRON ROD w/ ORANGE PLASTIC CAP #13427

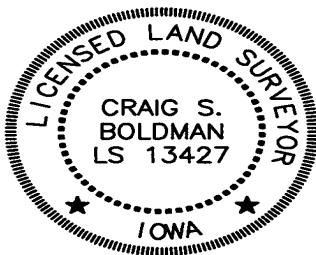

I hereby certify that this land surveying document was prepared and the related survey work was performed by me or under my direct supervision and that I am a duly licensed Land Surveyor under the laws of the State of Iowa

Signature: *Craig S. Boldman* Date: *5/8/23*  
 Name Craig S. Boldman P.L.S No. 13427  
 Renewal date is December 31, 2024  
 Pages or sheets covered by this seal: *All*