BK: 2024 PG: 1168

Recorded: 5/30/2024 at 8:09:45.0 AM

Pages 1


County Recording Fee: \$7.00 Iowa E-Filing Fee: \$3.00 Combined Fee: \$10.00 Revenue Tax: \$0.00

BRANDY L. MACUMBER, RECORDER

29 MAY 24

Date

Madison County, Iowa

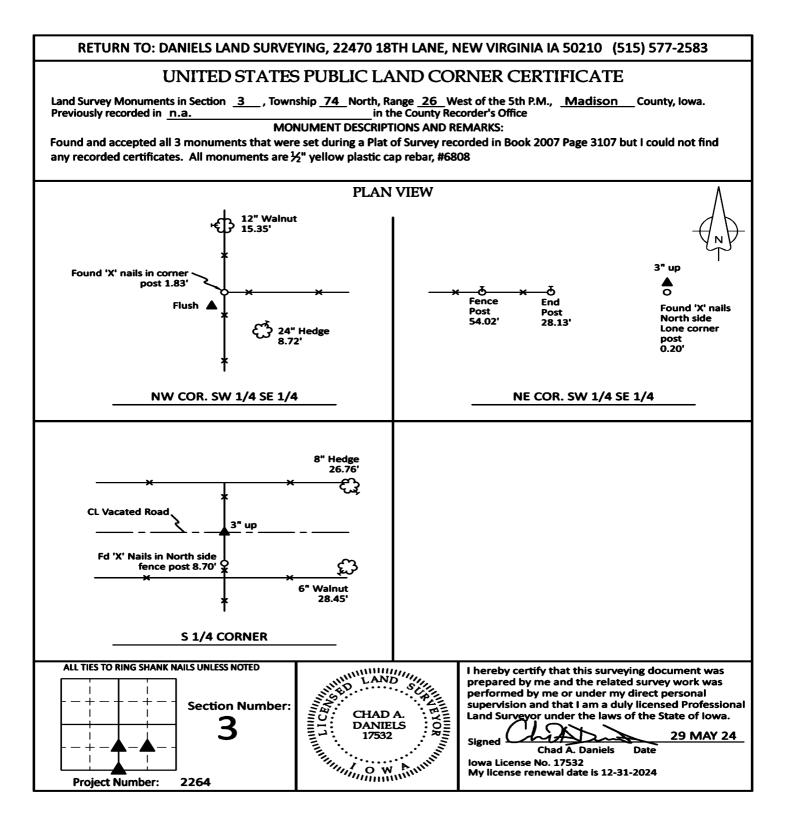

**Project Number:** 

2264

Signed <sup>1</sup>

Iowa License No. 17532

Chad A. Daniels

My license renewal date is 12-31-2024