


INDEX LEGEND

Location: Northwest Development Plat (1)
 Requestor: Abbie Chesling
 Proprietor: Abbie & Trey Chesling
 Project: 24039 Date of Survey: 7/2/2024
 Surveyor Co: Boldman Surveying & Consulting
 Prepared by/Return to: Craig S. Boldman
 521 West Green Street, Winterset, Ia 50273
 Phone/fax: 515-462-9242


BK: 2024 PG: 1602
 Recorded: 7/9/2024 at 10:12:14.0 AM
 Pages 1
 County Recording Fee: \$7.00
 Iowa E-Filing Fee: \$3.13
 Combined Fee: \$10.13
 Revenue Tax: \$0.00
BRANDY L. MACUMBER, RECORDER
 Madison County, Iowa

Boundary Retracement Survey (From Warranty Deed Book 2021 Page: 234)

Lot Four (4) of Northwest Development, Plat One (1), to the City of Winterset, Madison County, Iowa.

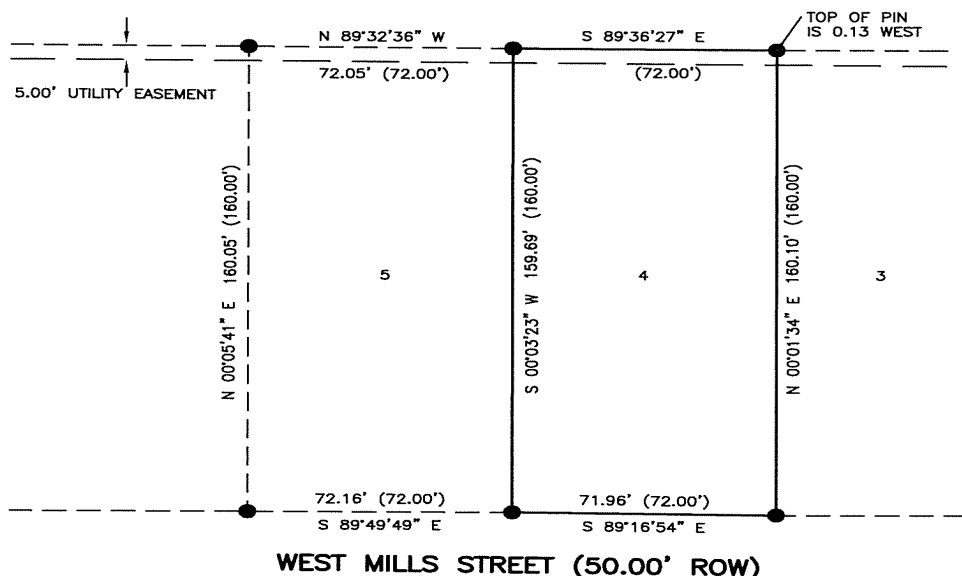

- LEGEND
- FOUND ORIGINAL MONUMENT
 - (XXX) RECORD PLAT OR DEED
 - Y.C.I.R. YELLOW CAPPED IRON ROD

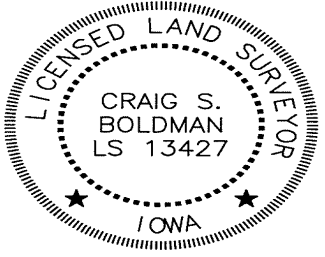

I hereby certify that this land surveying document was prepared and the related survey work was performed by me or under my direct supervision and that I am a duly licensed Land Surveyor under the laws of the State of Iowa

Signature: *Craig S. Boldman* Date: *7/5/24*

Name Craig S. Boldman P.L.S No. 13427

Renewal date is December 31, 2024

Pages or sheets covered by this seal: *All*