



BK: 2024 PG: 2369
 Recorded: 9/30/2024 at 1:19:18.0 PM
 Pages 1
 County Recording Fee: \$7.00
 Iowa E-Filing Fee: \$3.00
 Combined Fee: \$10.00
 Revenue Tax: \$0.00
 BRANDY L. MACUMBER, RECORDER
 Madison County, Iowa

RETRACEMENT SURVEY	SURVEY LEGEND
INDEX LEGEND	() - Recorded Distance/Bearing
LOCATION: Lot 4 of Block 1 of the Original Town Plat of Truro Madison County, Iowa	--- Interior Lot Line
OWNER: Andrew Leo Petersen 315 E North Street, Truro IA 50257	- - - Section line
SURVEY FOR: (Owner)	Monuments
ASSOCIATED DOCUMENTS: Warranty Deed: Book 2023 Page 3112	● - Set 1/2" red plastic capped rebar, #17532
PREPARED BY: CHAD A. DANIELS DANIELS LAND SURVEYING, 22470 18TH LN, NEW VIRGINIA IA 50210	○ - Found 1" Pipe
RETURN TO: 515-577-2583	■ - Found 1/2" yellow #6808
	□ - Found 1/2" rebar
	▲ - Found 4" Steel Channel
	◆ - Found 1" bar
	0 60 120 FEET
	BASIS OF BEARINGS IS IA RCS ZONE 8

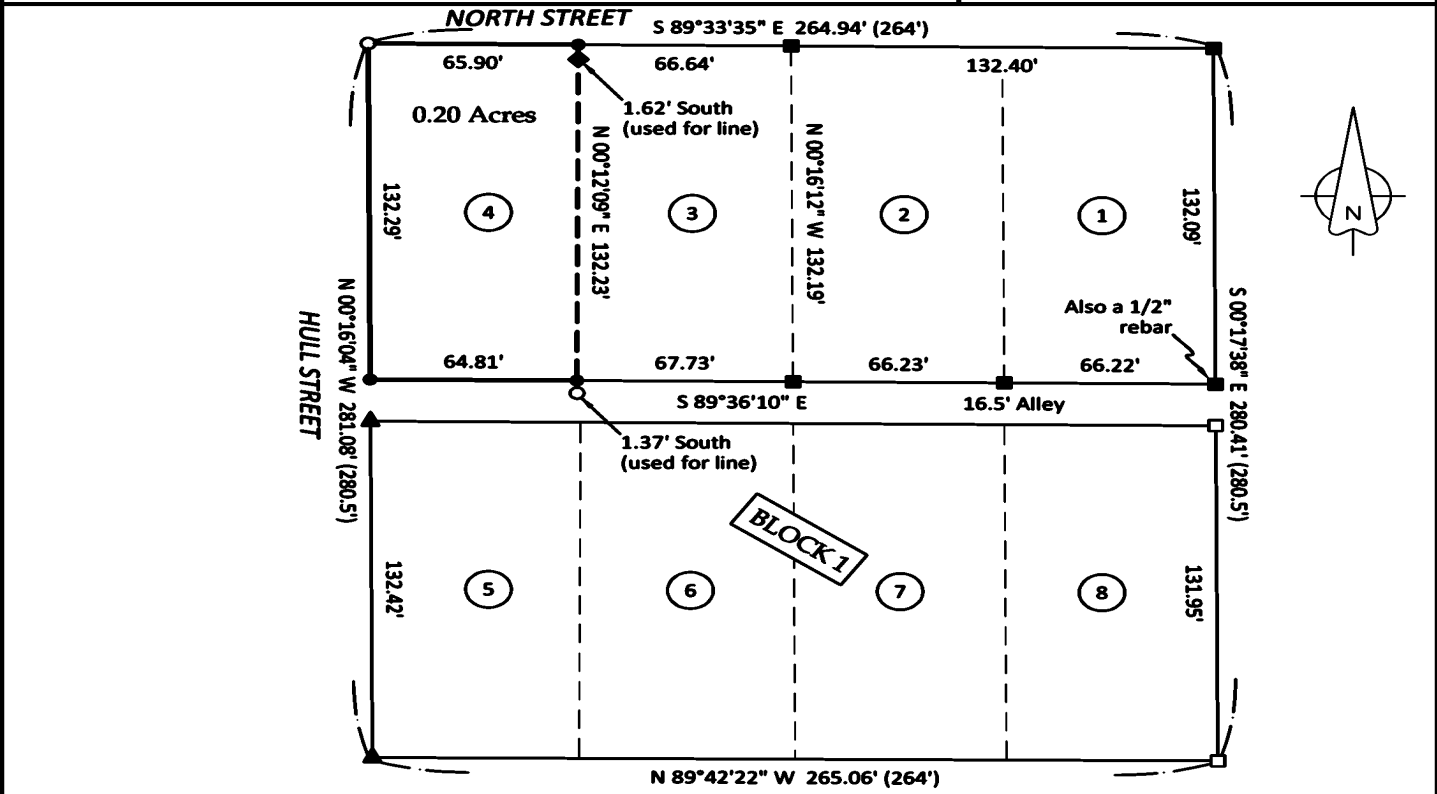

DESCRIPTION OF RECORD:
 Lot Four (4) in Block One (1) of the Original Town of Truro, formerly known as Ego, Madison County, Iowa.

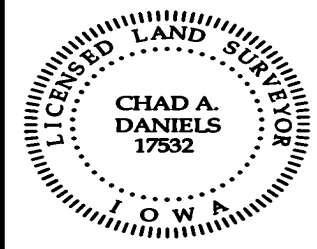

I hereby certify that this surveying document was prepared by me and the related survey work was performed by me or under my direct personal supervision and that I am a duly licensed Professional Land Surveyor under the laws of the State of Iowa.

Signed *Chad A. Daniels* 30 SEP 24
 Chad A. Daniels Date

Iowa License No. 17532
 My license renewal date is 12-31-2024
 Page No.'s covered by this seal: 1