BK: 2024 PG: 736
Recorded: 4/8/2024 at 1:45:35.0 PM
Pages 1
County Recording Fee: $7.00
Iowa E-Filing Fee: $3.00
Combined Fee: $10.00
Revenue Tax: $0.00
BRANDY L. MACUMBER, RECORDER
Madison County, Iowa

**RETURN TO: DANIELS LAND SURVEYING, 22470 18TH LANE, NEW VIRGINIA IA 50210 (515) 577-2583**


# UNITED STATES PUBLIC LAND CORNER CERTIFICATE

Land Survey Monuments in Section 34, Township 77 North, Range 28 West of the 5th P.M., Madison County, Iowa.
Previously recorded in n.a. in the County Recorder's Office

**MONUMENT DESCRIPTIONS AND REMARKS:**


Found ½" rebar, 1 foot deep, at the intersection of the County roads and in line with boundary fence North. Accepted position.

## PLAN VIEW

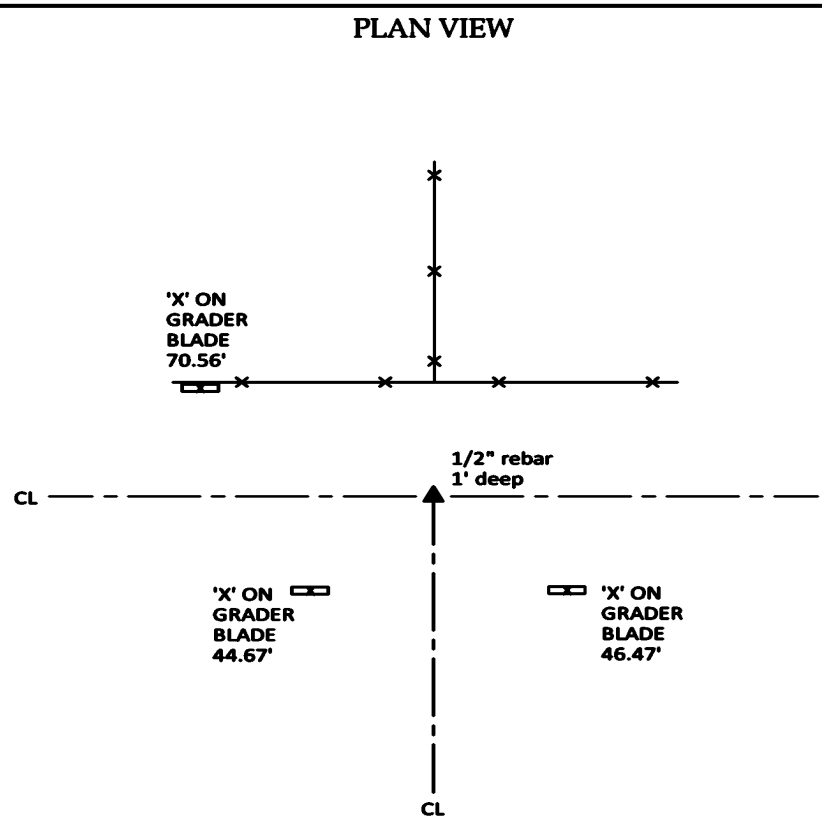


W 1/4 CORNER

ALL TIES TO RING SHANK NAILS UNLESS NOTED

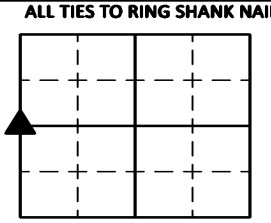

Section Number: 34

Project Number: 2232

LICENSED LAND SURVEYOR
CHAD A. DANIELS
17532
IOWA

I hereby certify that this surveying document was prepared by me and the related survey work was performed by me or under my direct personal supervision and that I am a duly licensed Professional Land Surveyor under the laws of the State of Iowa.

Signed _____ 8 APR 24
Chad A. Daniels Date

Iowa License No. 17532
My license renewal date is 12-31-2024