Document 2024 955

Book 2024 Page 955 Type 06 043 Pages 1
Date 5/03/2024 Time 8:17:01AM
Rec Amt $.00

INDX
ANNO
SCAN

BRANDY MACUMBER, COUNTY RECORDER
MADISON COUNTY IOWA

CHEK

Prepared By: Michael James Hackett, Madison County Engineer's Office, 1105 E. Court Ave., Winterset, Ia. 50273, Tel. (515) 462-1136
Return To: Michael James Hackett, Madison County Engineer's Office, 1105 E. Court Ave., Winterset, Ia. 50273, Tel. (515) 462-1136

UNITED STATES PUBLIC LAND SURVEY CORNER CERTIFICATE OF


Land Survey Monuments situated in Section 10, Township 75 N, Range 26 W, of the Fifth Principal Meridian, Madison County,Iowa.
Previously recorded in Book 1, Page 320 in County Recorder's Office.
(book, page, document number,etc.)

(Show reason for preparing this certificate, the evidence and detailed procedures used in establishing the corner positions and monumentation found or placed.)

Monument Description and Remarks: Found ½" iron rod with yellow plastic cap #5041, 6" deep in county highway. Confirmed the position of the corner from Madison County bridge replacement project control (BROS-SWAP-C061(116)--SE-61) and previously recorded ties. Accepted position. This certificate was prepared because some of the ties have been disturbed and the found tie distances was slightly different than previously recorded.

PLAN VIEW

(Show a minimum of three reference ties to durable physical objects, relevant monuments and physical conditions that will enable recovery of the corner.)

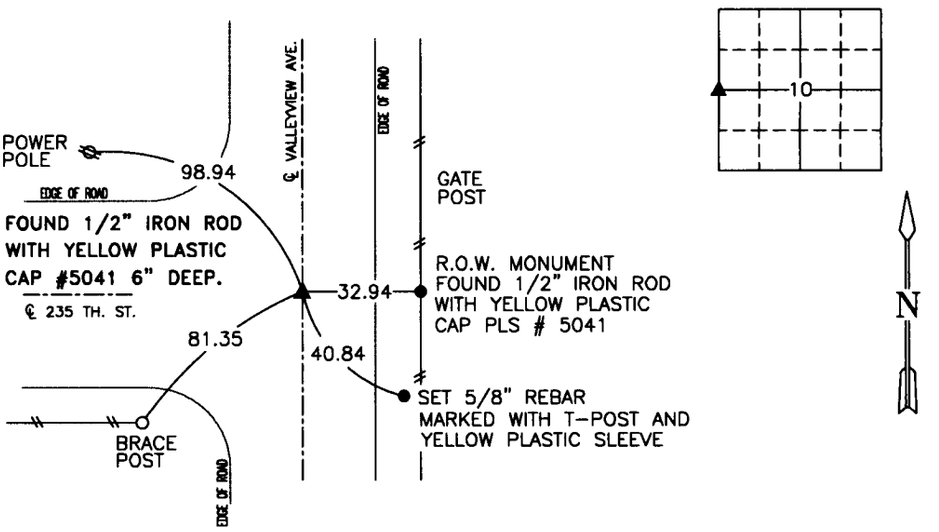

NW. COR., NW 1/4, SW. 1/4, SEC. 10

NOTE: ALL TIES TO "X" NAILS UNLESS NOTED

LICENSED PROFESSIONAL ENGINEER & LAND SURVEYOR
MICHAEL JAMES HACKETT 14672
IOWA

I hereby certify that this land surveying document was prepared and the related survey work was performed by me or under my direct personal supervision and that I am a duly Licensed Land Surveyor under the laws of the State of Iowa.

Signed _____ Date 4/29/2024
Michael James Hackett

Iowa license number 14672.
My license renewal date is 12/31/2024.
Pages covered by this seal: 1.

BROS-SWAP-C061(116)--SE-61
G-13