Document 2025 1256

Book 2025 Page 1256 Type 06 043 Pages 1
Date 5/22/2025 Time 3:02:58PM
Rec Amt $.00

INDX
ANNO
SCAN

BRANDY MACUMBER, COUNTY RECORDER
MADISON COUNTY IOWA

CHEK

Prepared By: Michael James Hackett, Madison County Engineer's Office, 1105 E. Court Ave., Winterset, Ia. 50273, Tel. (515) 462-1136
Return To: Michael James Hackett, Madison County Engineer's Office, 1105 E. Court Ave., Winterset, Ia. 50273, Tel. (515) 462-1136

UNITED STATES PUBLIC LAND SURVEY CORNER CERTIFICATE OF


Land Survey Monuments situated in Section 19, Township 74 N, Range 29 W, of the Fifth Principal Meridian, Madison County,Iowa.
Previously recorded in Book 2016, Page 730 in County Recorder's Office.
(book, page, document number,etc.)


(Show reason for preparing this certificate, the evidence and detailed procedures used in establishing the corner positions and monumentation found or placed.)

Monument Description and Remarks: Found ½" rebar 6" deep with yellow 11808 cap. Previous ties were removed during county highway project STP-S-C061(128)--5E-61. Accepted position of existing monument position by using the existing found monument, previous ties, and ties established during construction.

PLAN VIEW

(Show a minimum of three reference ties to durable physical objects, relevant monuments and physical conditions that will enable recovery of the corner.)

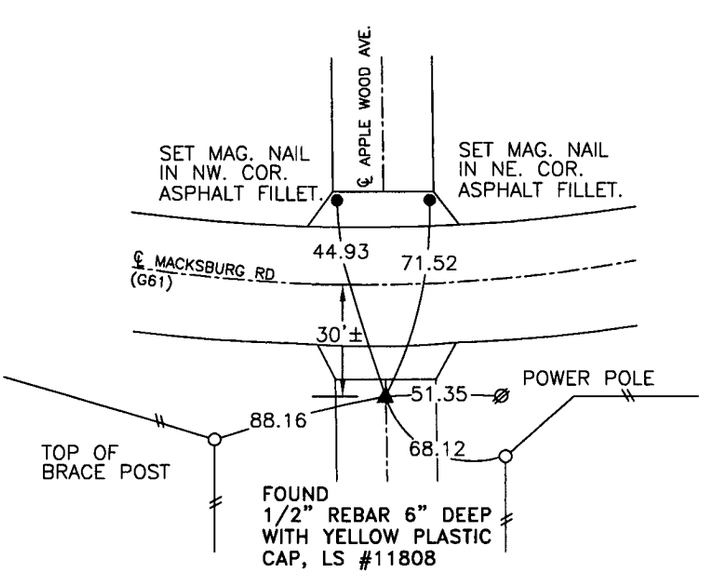

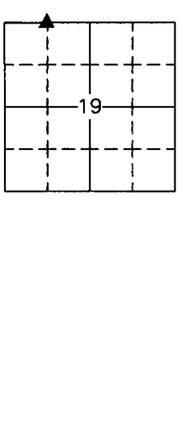

NW. COR., NE. 1/4, NW 1/4 SEC. 19

NOTE: ALL TIES TO "X" NAILS UNLESS NOTED

LICENSED PROFESSIONAL ENGINEER & LAND SURVEYOR
MICHAEL JAMES HACKETT
14672
IOWA

I hereby certify that this land surveying document was prepared and the related survey work was performed by me or under my direct personal supervision and that I am a duly Licensed Land Surveyor under the laws of the State of Iowa.

Signed _____ Date 5/20/2025
Michael James Hackett

Iowa license number 14672.
My license renewal date is 12/31/2026.
Pages covered by this seal: 1.

STP-S-C061(128)--5E-61
N-2