INDEX LEGEND

LOCATION:

PARCEL "K"
(NWFRL1/4 NW1/4 & SWFRL1/4 NW1/4)
SEC. 19, T-76-N, R-27-W
MADISON COUNTY, IOWA.

PROPRIETOR:

WILLIAM T. COLLINS & J THOMAS COLLINS
REQUESTED BY:
FARMERS NATIONAL COMPANY
PREPARED BY:
JOSHUA E. SCHNEIDER
COMPANY:
GARDEN & ASSOCIATES, LTD.

BK: 2025 PG: 3307


Recorded: 12/5/2025 at 10:24:41.0 AM

Pages 2

County Recording Fee: \$12.00 lowa E-Filing Fee: \$3.00 Combined Fee: \$15.00 Revenue Tax: \$0.00

BRANDY L. MACUMBER, RECORDER

Madison County, Iowa

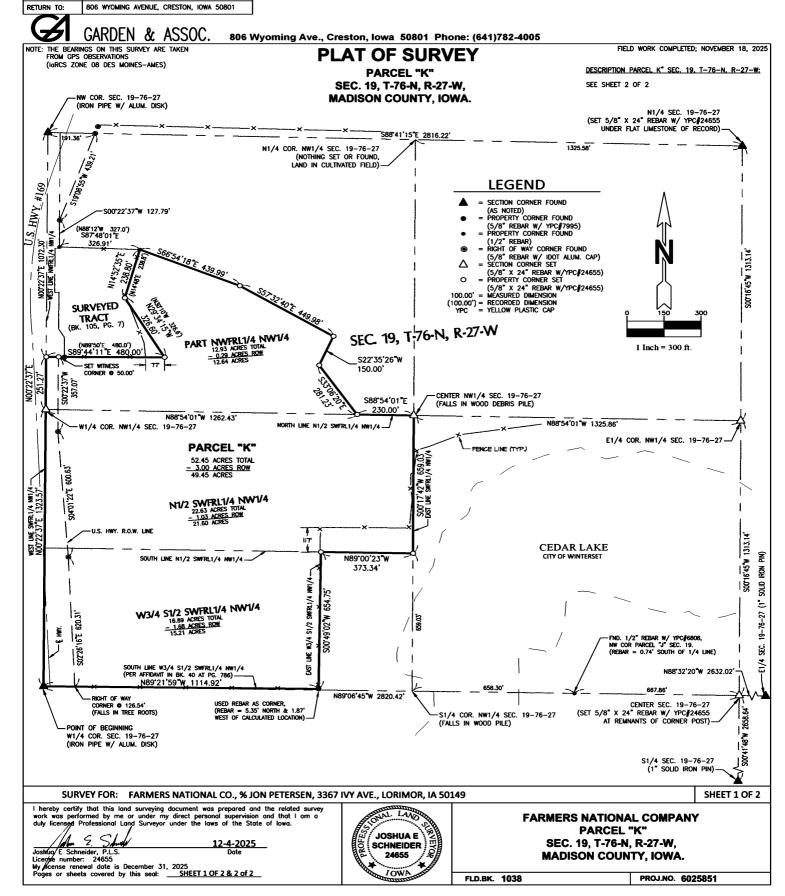



## **PLAT OF SURVEY**

## DESCRIPTION PARCEL "K" SEC. 19. T-76-N. R-27-W:

A PARCEL OF LAND LOCATED IN THAT PORTION OF THE NWFRL1/4 OF THE NW1/4 AND ALL OF THE N1/2 OF THE SWFRL1/4 OF THE NW1/4 AND THE W3/4 OF THE S1/2 OF THE SWFRL1/4 OF THE NW1/4, ALL IN SECTION 19, TOWNSHIP 76 NORTH, RANGE 27 WEST OF THE 5TH P.M. IN MADISON COUNTY, IOWA, MORE PARTICULARLY DESCRIBED AS FOLLOWS;

BEGINNING AT A FOUND IRON PIPE AT THE W1/4 CORNER OF SAID SECTION 19, THENCE NO0'22'37"E ALONG THE WEST LINE OF THE SWFRL1/4 OF THE NW1/4 OF SAID SECTION 19 A DISTANCE OF 1323.57' TO A SET 5/8" REBAR AT THE W1/4 CORNER OF THE NW1/4 OF SAID SECTION 19, THENCE NOO'22'37"E ALONG THE WEST LINE OF THE NWFRL1/4 OF THE NW1/4 OF SAID SECTION 19 A DISTANCE OF 251.27' TO A SET 5/8" REBAR AT THE SW CORNER OF A SURVEYED TRACT OF LAND AS SHOWN ON A PLAT OF SURVEY RECORDED IN DEED BOOK 105 AT PAGE 7 IN THE RECORDS OF THE MADISON COUNTY RECORDER, THENCE S89'44'11"E ALONG THE SOUTH LINE OF SAID SURVEYED TRACT OF LAND A DISTANCE OF 480.00' TO A SET 5/8" REBAR AT THE SE CORNER OF SAID SURVEYED TRACT OF LAND, THENCE THE FOLLOWING 2 COURSES ALONG THE EASTERLY LINES OF SAID SURVEYED TRACT OF LAND, N29'34'15"W A DISTANCE OF 326.60' TO A SET 5/8" REBAR, THENCE N14'52'35"E A DISTANCE OF 238.80' TO A FOUND 1/2 REBAR AT THE NE CORNER OF SAID SURVEYED TRACT OF LAND, THENCE S66'54'18"E A DISTANCE OF 439.99' TO A SET 5/8" REBAR, THENCE S57"32'40"E A DISTANCE OF 449.98' TO A SET 5/8" REBAR, THENCE S22"35'26"W A DISTANCE OF 150.00' TO A SET 5/8" REBAR, THENCE S33"06'20"E A DISTANCE OF 281.23' TO A SET 5/8" REBAR ON THE NORTH LINE OF THE N1/2 OF THE SWFRL1/4 OF THE NW1/4 OF SAID SECTION 19, THENCE S88'54'01"E ALONG THE NORTH LINE OF THE N1/2 OF THE SWFRL1/4 OF THE NW1/4 OF SAID SECTION 19 A DISTANCE OF 230.00' TO SET 5/8" REBAR AT THE CENTER OF THE NW1/4 OF SAID SECTION 19, THENCE SOO'17'42"W ALONG THE EAST LINE OF THE N1/2 OF THE SWFRL1/4 OF THE NW1/4 OF SAID SECTION 19 A DISTANCE OF 659.03' TO A SET 5/8" REBAR AT THE SE CORNER OF THE N1/2 OF THE SWFRL1/4 OF THE NW1/4 OF SAID SECTION 19, THENCE N89'00'23"W ALONG THE SOUTH LINE OF THE N1/2 OF THE SWFRL1/4 OF THE NW1/4 OF SAID SECTION 19 A DISTANCE OF 373.34' TO A SET 5/8" REBAR AT THE NE CORNER OF THE W3/4 OF THE SWFRL1/4 OF THE NW1/4 OF SAID SECTION 19, THENCE SOO'49'02"W ALONG THE EAST LINE OF THE W3/4 OF THE S1/2 OF THE SWFRL1/4 OF THE NW1/4 OF SAID SECTION 19 A DISTANCE OF 654.75' TO A FOUND 5/8" REBAR AT THE SE CORNER OF THE W3/4 OF THE S1/2 OF THE SWFRL1/4 OF THE NW1/4 OF SAID SECTION 19 THENCE N89'21'59"W ALONG THE SOUTH LINE OF THE W3/4 OF THE S1/2 OF THE SWFRL1/4 OF THE NW1/4 OF SAID SECTION 19 A DISTANCE OF 1114.92' TO THE POINT OF BEGINNING, CONTAINING 52.45 ACRES, SUBJECT TO EASEMENTS FOR A PUBLIC HIGHWAY RECORDED IN BOOK 70 AT PAGE 370 AND BOOK 127 AT PAGE 12 AND ANY OTHER EASEMENTS OF RECORD.

SHEET 2 OF 2

FARMERS NATIONAL COMPANY PARCEL "K" SEC. 19, T-76-N, R-27-W, MADISON COUNTY, IOWA.

FLD.BK. 1038

PROJ.NO. 6025851