BK: 2025 PG: 574

Recorded: 3/10/2025 at 3:04:46.0 PM

Pages 1

County Recording Fee: \$7.00 Iowa E-Filing Fee: \$3.00 Combined Fee: \$10.00 Revenue Tax: \$0.00

BRANDY L. MACUMBER, RECORDER

Madison County, Iowa

RETRACEMENT SURVEY

INDEX LEGEND

LOCATION: Parcel D of the SW 1/4 of the NW 1/4 of Section 34,

T 77N, R 26W, Madison County, Iowa

OWNER: **Adam & Amber Bonnett**

3107 155th Street, Cumming IA 50061

SURVEY FOR: (Owner)

ASSOCIATED Plat of Survey: Book 2015 Page 647 DOCUMENTS: Warranty Deed: Book 2024 Page 2968

CHAD A. DANIELS PREPARED BY

DANIELS LAND SURVEYING, 22470 18TH LN, NEW VIRGINIA IA 50210 **RETURN TO:** 515-577-2583

SURVEY LEGEND

() - Recorded Distance/Bearing - 33' Road Easement

- Section line


Monuments

▲ - Found section corner

Set 12" spike

w/ brass washer, #17532
- Found 1/2" yellow #6808
- Found 1/2" yellow #5041

BASIS OF BEARINGS IS W LINE OF PCL D

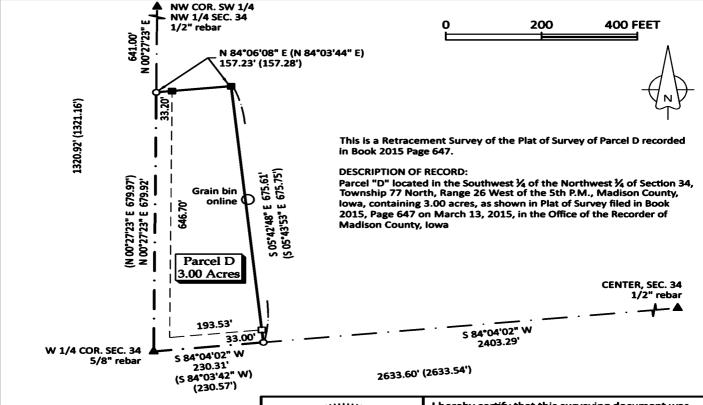

AREA BY TRACT: TRACT: NET (AC): R.O.W. (AC): TOTAL (AC): PARCEL D 2.34 0.66 3.00 TOTAL 2.34 0.66 3.00



I hereby certify that this surveying document was prepared by me and the related survey work was performed by me or under my direct personal supervision and that I am a duly licensed Professional Land Surveyor under the laws of the State of Iowa.

10 MAR 25 Signed ¹ Chad A. Daniels Date

lowa License No. 17532 My license renewal date is 12-31-2026 Page No.'s covered by this seal: 1

PROJ. NO. 2391 DATE OF SURVEY: 10 MARCH 2025