

Document 2025 676

Book 2025 Page 676 Type 06 043 Pages 1 Date 3/21/2025 Time 2:30:28PM Rec Amt \$.00

INDX **ANNO SCAN**

BRANDY MACUMBER, COUNTY RECORDER MADISON COUNTY IOWA

CHEK


Prepared By: Michael James Hackett, Madison County Engineer's Office, 1105 E. Court Ave., Winterset, la. 50273, Tel. (515) 462-1136 Return To: Michael James Hackett, Madison County Engineer's Office, 1105 E. Court Ave., Winterset, Ia. 50273, Tel. (515) 462-1136


UNITED STATES PUBLIC LAND SURVEY CORNER CERTIFICATE OF

Land Surve	y Monuments :	situated in Section	2	, Township	<u> </u>
27 W	<u>i</u> ,	of the Fifth Princi	ipal Meridian, 🗕	<u> Madison</u>	County,lowa.
Previously	recorded in	Book 1, Page 19	<u>7</u>	in Cour	nty Recorder's Office
•		(book, page, docu	ment number,etc.)		•
	for preparing this of found or placed.)	certificate, the evidence o	and detailed proced	ures used in establishir	ng the corner positions and
Monument	Description and	d Remarks: Found	½" iron rod with	no cap 3 inches deep	in county highway.
		northeast quarter to co	onfirm the position	. This certificate was	prepared because the
ties from the	previously record	ed corner certificate ha	ive been destroyed	l.	

PLAN VIEW


(Show a minimum of three reference ties to durable physical objects, relevant monuments and physical conditions that will enable recovery of the corner.)

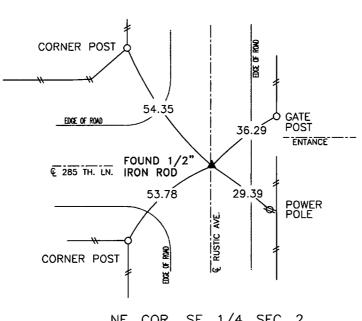

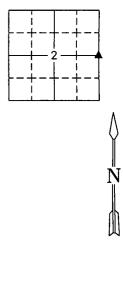

NE. COR., SE. 1/4, SEC. 2

NOTE: ALL TIES TO "X" NAILS UNLESS NOTED

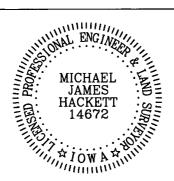

I hereby certify that this land surveying document was prepared and the related survey work was performed by me or under my direct personal supervision and that I am a duly Licensed Land Surveyor under the laws of the State of Iowa.

Michael James Hackett

lowa license number 14672. My license renewal date is 12/31/2026. Pages covered by this seal: 1.

BROS-C061(132)--5F-61