

Book 2025 Page 677 Type 06 043 Pages 1 Date 3/21/2025 Time 3:10:54PM

Rec Amt \$.00

INDX **ANNO** SCAN

BRANDY MACUMBER, COUNTY RECORDER MADISON COUNTY IOWA

CHEK


Prepared By: Michael James Hackett, Madison County Engineer's Office, 1105 E. Court Ave., Winterset, Ia. 50273, Tel. (515) 462-1136 Return To: Michael James Hackett, Madison County Engineer's Office, 1105 E. Court Ave., Winterset, Ia. 50273, Tel. (515) 462-1136

## UNITED STATES PUBLIC LAND SURVEY CORNER CERTIFICATE OF

Land Survey Monuments situated in Section, Town	nship, Range
, of the Fifth Principal Meridian,Madis	son County,lowa.
Previously recorded in Book 2007, Page 1608	_ in County Recorder's Office.
(book, page, document number,etc.)	•
(Show reason for preparing this certificate, the evidence and detailed procedures used i monumentation found or placed.)	in establishing the corner positions and
Monument Description and Remarks: Found ½" rebar with yellow plastic	cap, #6808, 1 inch deep in county
highway. Traversed east line of the northeast quarter to confirm position. This cer	tificate was prepared because the
ties from the previously recorded corner certificate have been destroyed.	


## PLAN VIEW

(Show a minimum of three reference ties to durable physical objects, relevant monuments and physical conditions that will enable recovery of the corner.)

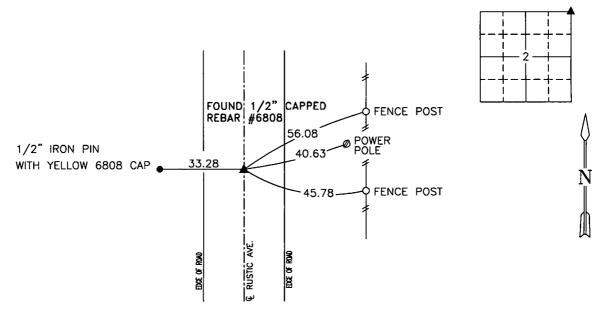

NE. COR., NE. 1/4 SEC. 2

NOTE: ALL TIES TO "X" NAILS UNLESS NOTED

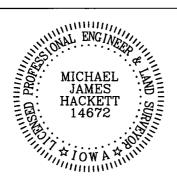

I hereby certify that this land surveying document was prepared and the related survey work was performed by me or under my direct personal supervision and that I am a duly Licensed Land Surveyor under the hows of the State of lowa. Surveyor under State of lowa.

Michael James Hackett

lowa license number 14672. My license renewal date is 12/31/2026. Pages covered by this seal: 1.

BROS-C061(132)--5F-61

A-21