BK: 2026 PG: 3172
Recorded: 10/26/2026 at 9:18:54.0 AM
Pages 1
County Recording Fee: $7.00
Iowa E-Filing Fee: $3.13
Combined Fee: $10.13
Revenue Tax: $0.00
BRANDY L. MACUMBER, RECORDER
Madison County, Iowa

PREPARED BY: CRAIG S. BOLDMAN 521 WEST GREEN STREET.WINTERSET, IA 50273 PHONE (515)462-9242

UNITED STATES PUBLIC LAND SURVEY CORNER CERTIFICATE

Land Survey Monuments situated in Section 33, Township 76, Range 26, the Fifth Principal Meridian, Madison County, Iowa.
Previously recorded in Book 1 Page 193 in County Recorder's Office


(Show reason for preparing this certificate,the evidence and detailed procedures used in establishing the corner positions & monumentation found or placed)

Monument Description and Remarks:

Retied because ties were missing.

PLAN—VIEW

Northwest Corner

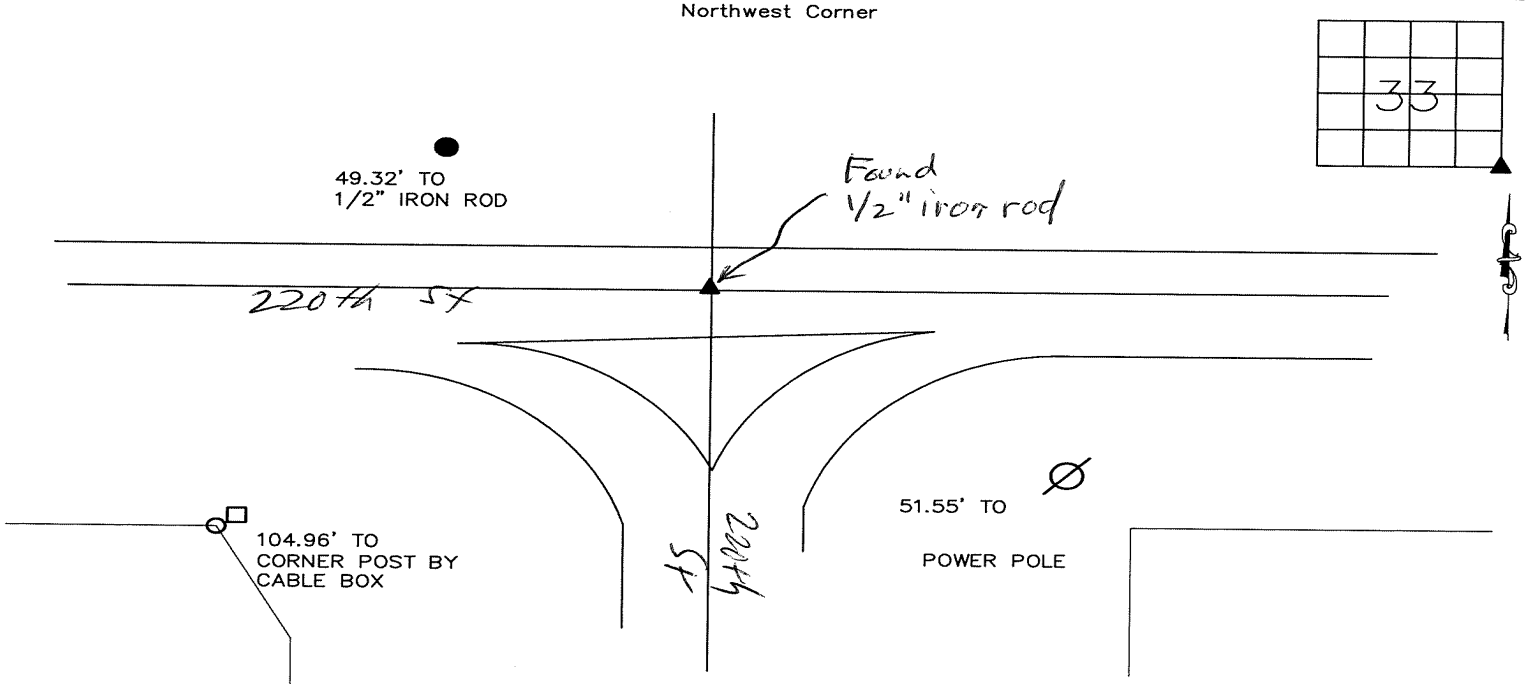

NOTE: ALL TIES TO ORANGE PLASTIC SURVEY MARKERS (SM) UNLESS NOTED

I HEREBY CERTIFY THAT THIS LAND SURVEYING DOCUMENT WAS PREPARED AND THE RELATED SURVEY WORK WAS PERFORMED BY ME OR UNDER MY DIRECT PERSONAL SUPERVISION AND THAT i AM A DULY LICENSED LAND SURVEYOR UNDER THE LAWS OF THE STATE OF IOWA

SIGNATURE _____
CRAIG S. BOLDMAN

DATE: 10/24/26 LICENSE NO 13427

MY RENEWAL DATE IS DECEMBER 31, 2026

COVERS SHEETS This Sheet

LICENSED LAND SURVEYOR
CRAIG S. BOLDMAN
LS 13427
IOWA

CORNERS TO BE INDEXED

Corners	Section	Township	Range
SE	33	76	26
SW	34	76	26
NW	3	75	26
NE	4	75	26

Project No. 26047