BK: 2026 PG: 3353
Recorded: 11/10/2026 at 8:40:40.0 AM
Pages 1
County Recording Fee: $7.00
Iowa E-Filing Fee: $3.00
Combined Fee: $10.00
Revenue Tax: $0.00
BRANDY L. MACUMBER, RECORDER
Madison County, Iowa

RETRACMENT SURVEY

INDEX LEGEND

LOCATION: East line of the W ½ of the NW ¼ of Section 25, T 74N, R 26W, Madison County, Iowa

OWNER: Elizabeth A Palmer Revocable Trust
3248 305th Lane, Truro IA 50257

SURVEY FOR: (Owner)

ASSOCIATED DOCUMENTS: Corrected Quit Claim Deed: Book 2026 Page 1522

PREPARED BY RETURN TO: CHAD A. DANIELS
DANIELS LAND SURVEYING, 22470 18TH LN, NEW VIRGINIA IA 50210
515-577-2583


SURVEY LEGEND

( ) - Recorded Distance/Bearing

— · — · — Section line
—×—×— Fence line

Monuments
▲ - Found section corner
● - Set 1/2" red plastic capped rebar, #17532

BASIS OF BEARINGS IS IA RCS ZONE 8

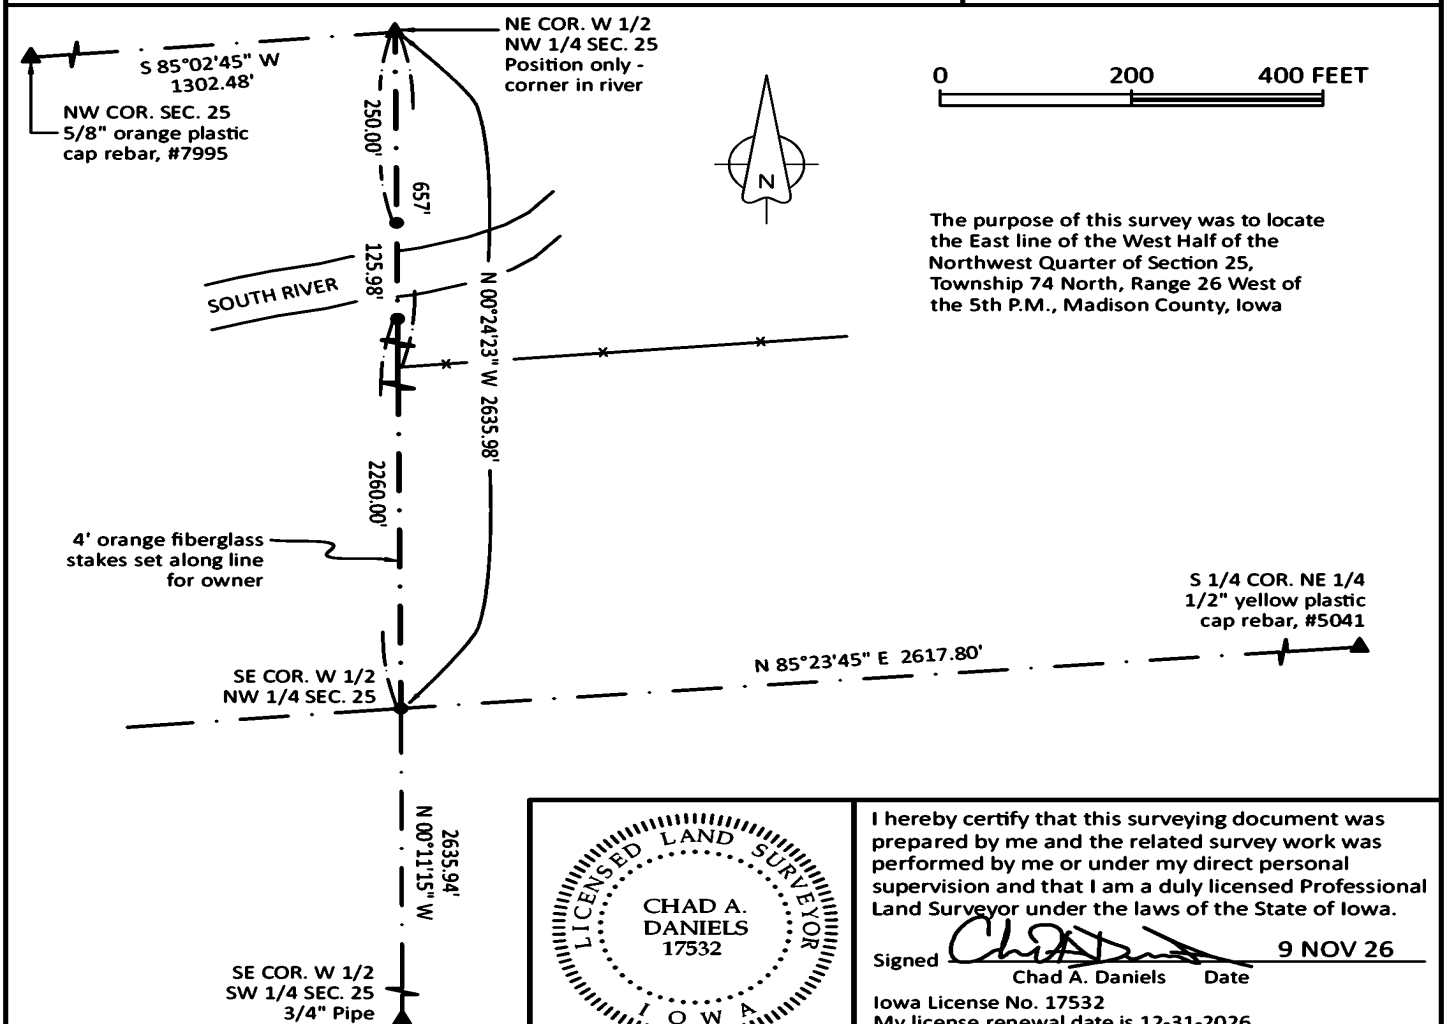

The purpose of this survey was to locate the East line of the West Half of the Northwest Quarter of Section 25, Township 74 North, Range 26 West of the 5th P.M., Madison County, Iowa

LICENSED LAND SURVEYOR
CHAD A. DANIELS
17532
IOWA

I hereby certify that this surveying document was prepared by me and the related survey work was performed by me or under my direct personal supervision and that I am a duly licensed Professional Land Surveyor under the laws of the State of Iowa.

Signed _____ 9 NOV 26
Chad A. Daniels Date

Iowa License No. 17532
My license renewal date is 12-31-2026
Page No.'s covered by this seal: 1

PROJ. NO. 2706 | DATE OF SURVEY: 6 NOVEMBER 2026 | PAGE 1 of 1