Document 2009 2353

Book 2009 Page 2353 Type 06 043 Pages 1
Date 7/23/2009 Time 2:26 PM
Rec Amt $9.00

INDX ✓
ANNO
SCAN

LISA SMITH. COUNTY RECORDER
MADISON COUNTY IOWA

CHEK

VANCE & HOCHSTETLER, P.C., CONSULTING ENGINEERS, WINTERSET, IOWA (515) 462-3995
CHARLES T. VANCE, 110 West Green St., Winterset, Iowa, 50273
JAMES M HOCHSTETLER, 110 West Green St., Winterset, Iowa 50273

09-705

UNITED STATES PUBLIC LAND SURVEY CORNER CERTIFICATE

OF

Land Survey Monuments situated in Section 20, Township 77 N, Range 26W, of the Fifth Principal Meridian, MADISON County, Iowa.

Previously recorded in _____ (book, page, document number, etc.) in County Recorder's Office.


(Show reason for preparing this certificate, the evidence and detailed procedures used in establishing the the corner positions and monumentation found or placed.)


Monument Description and Remarks: S¼ Cor. - Found CIR #6808 at ℄ County Road and in line with property line fences East and West.

SW COR - Set yellow CIR #6808 at three way fence corner.

PLAN - VIEW

(Show a minimum of three reference ties to durable physical objects, relevant monuments and physical conditions that will enable recovery of the corner.)

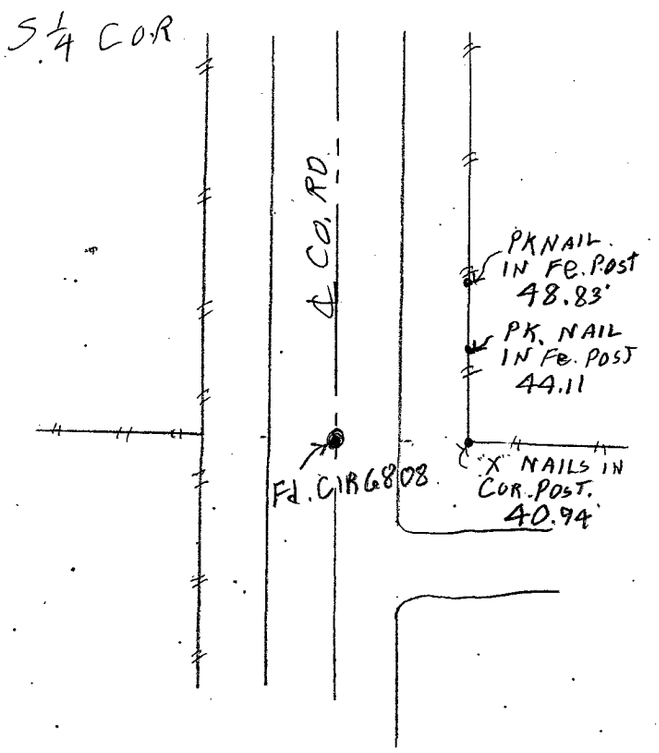

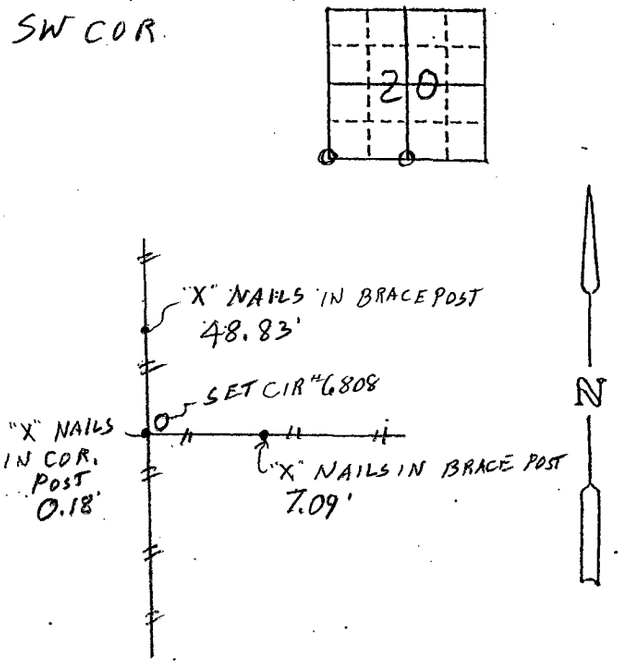



I hereby certify that this land surveying document was prepared and the related survey work was performed by me or under my direct personal supervision and that I am a duly licensed Land Surveyor under the laws of the State of Iowa.

J.M. Hochstetler

J.M. HOCHSTETLER

License number 6808 Date 7/21/09

My license renewal date is December 31, 2009

Pages or sheets covered by this seal: 1

List Corners to be Indexed

Corners	Section	Twp	Range
S¼ Cor.	20	77N	26W
SW Cor.	20	77N	26W