Document 2009 2428

LISA SMITH, COUNTY RECORDER
MADISON COUNTY IOWA

Book 2009 Page 2428 Type 06 043 Pages 1
Date 7/30/2009 Time 3:21 PM
Rec Amt $9.00

INDX ✓
ANNO
SCAN
CHEK

Prepared by: Boldman Surveying Consultants Address: 521 West Green Street, Winterset, Ia. 50273 Phone: (515)462-9242

UNITED STATES PUBLIC LAND SURVEY CORNER CERTIFICATE FOR

Land survey monuments situated in Section 23, Township 76 Range 29, of the Fifth Principal Meridian, Madison County, Iowa.


Previously recorded in None found in County Recorder's Office.

(Show reason for preparing this certificate, the evidence and detailed procedures used in establishing the corner positions & monumentation found or placed.)

MONUMENT DESCRIPTION AND REMARKS: SW Cor SE1/4 NW1/4-Set 1/2" pin & cap at old corner post.

PLAN – VIEW

(Show a minimum of three reference ties to durable physical objects, relevant monuments and physical conditions that will enable recovery of the corner.)

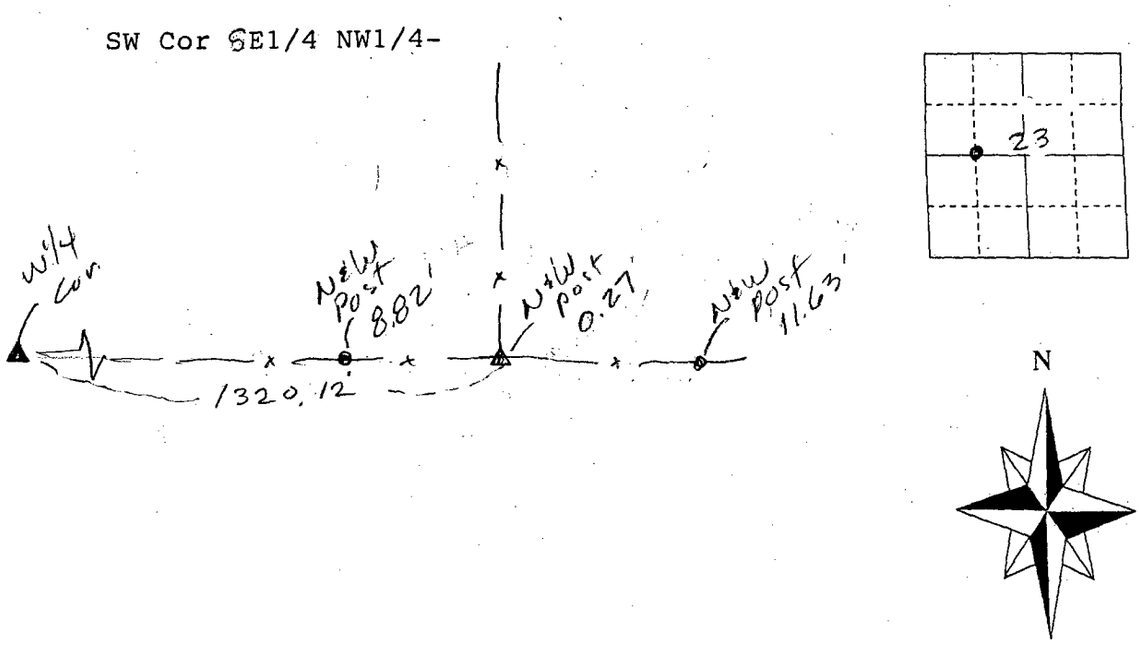

SEAL

LICENSED LAND SURVEYOR
CRAIG S. BOLDMAN
13427
IOWA

I hereby certify that this land surveying document was prepared and the related survey work was performed by me or under my direct personal supervision and that I am a duly licensed Land Surveyor under the laws of the State of Iowa.

Signature 1-1-09 Date

Typed/Printed Name: Craig S. Boldman

License Number: 13427

My license renewal date is December 31, 2010.

Pages or sheets covered by this seal: _____

Corners to be Indexed

Corners	Section	Twp.	Range
SW Cor. SE¼NW¼	23	76	29

SLSI–3/98

Job #08048