

Document 2009 2568

Book 2009 Page 2568 Type 06 026 Pages 1 Date 8/13/2009 Time 10:29 AM

Rec Amt \$7.00

INDX **ANNO** SCAN

LISA SMITH, COUNTY RECORDER MADISON COUNTY IOWA

CHEK


DANIELS LAND SURVEYING, 22598 18TH AVE, NEW VIRGINIA, IA 50210 641-449-3259

RETRACEMENT SURVEY

S 1/2, LOTS 1 & 2, BLOCK 10, HARTMAN & YOUNG'S ADDITION TOWN OF ST. CHARLES, MADISON COUNTY, IOWA

100 FEET

MAIN ST - 82'

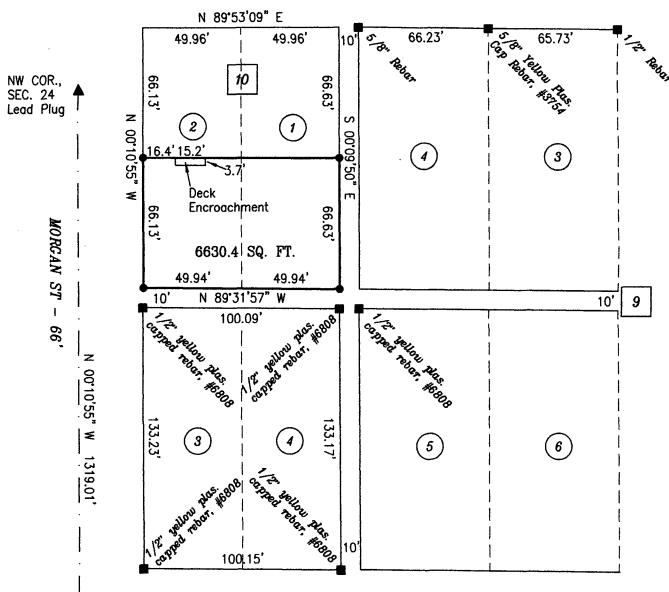

SYCAMORE ST - 66'

SW COR., NW 1/4, NW 1/4, SEC. 24-75-26 Cut 'X' Cut

DESCRIPTION OF RECORD:

The South Half (S 1/2) of Lots One (1) and Two (2) in Half Block Ten (10) of the Additional Lots (commonly known as Hartman & Young's Addition) in the town of St. Charles, Madison County, Iowa

subject to easements, covenants and restrictions of record, if any.

BASIS OF BEARINGS IS GPS NORTH

) - Recorded Distance/Bearing

Lot Line

- · — Section line

Monuments

Found section corner
Set 1/2" red plastic capped rebar, #17532

- Found property corner



I hereby certify that this surveying document was prepared by me and the related survey work was performed by me or under my direct personal supervision and that I am a duly licensed Land Surveyor under the laws of the State of lowa.

8/11/2009 Signed \ Chad A. Daniels

lowa License No. 17532 My license renewal date is 12-31-2010 Page No.'s covered by this seal: 1

SURVEY FOR AND OWNER: Anne Cassady, Denver, CO 80210 2657 South Race St

07/29/2009 DATE OF SURVEY: PROJ. NO. 212

PAGE 1