Document 2009 2810

Book 2009 Page 2810 Type 06 043 Pages 1
Date 9/09/2009 Time 12:05 PM
Rec Amt $9.00

INDX ✓
ANNO
SCAN

LISA SMITH, COUNTY RECORDER
MADISON COUNTY IOWA

CHEK

VANCE & HOCHSTETLER, P.C., CONSULTING ENGINEERS, WINTERSET, IOWA (515) 462-3995
CHARLES T. VANCE, 110 West Green St., Winterset, Iowa, 50273
JAMES M HOCHSTETLER, 110 West Green St., Winterset, Iowa 50273

09-833

UNITED STATES PUBLIC LAND SURVEY CORNER CERTIFICATE

OF

Land Survey Monuments situated in Section 35, Township 77N, Range 26W, of the Fifth Principal Meridian, MADISON County, Iowa.
Previously recorded in _____ in County Recorder's Office.
(book, page, document number, etc.)


(Show reason for preparing this certificate, the evidence and detailed procedures used in establishing the the corner positions and monumentation found or placed.)


Monument Description and Remarks: E ¼ COR. – Set yellow CIR #6808 3" deep at ℄ East/West County Road in line with an old property line fence South. Old road records at the County Engineer's office indicate that the dead end road North is on the section line but old fences and distance measurements indicate the road is all in Section 35.

NW COR SW ¼ NE ¼ - Set yellow CIR #6808 at property line fence corner of old fences North, South and East. Line matches line to fence at approximate NW corner of Section.

PLAN - VIEW

(Show a minimum of three reference ties to durable physical objects, relevant monuments and physical conditions that will enable recovery of the corner.)

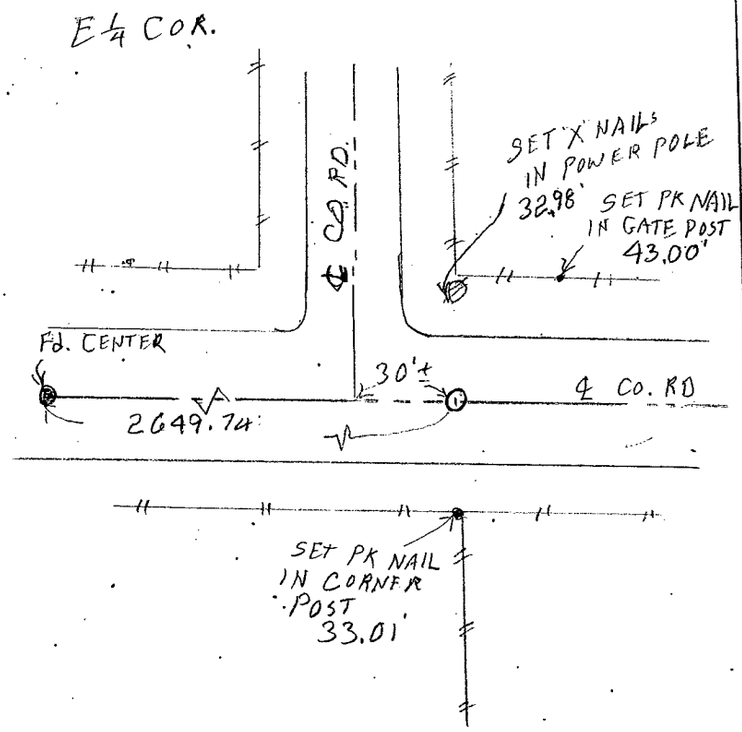

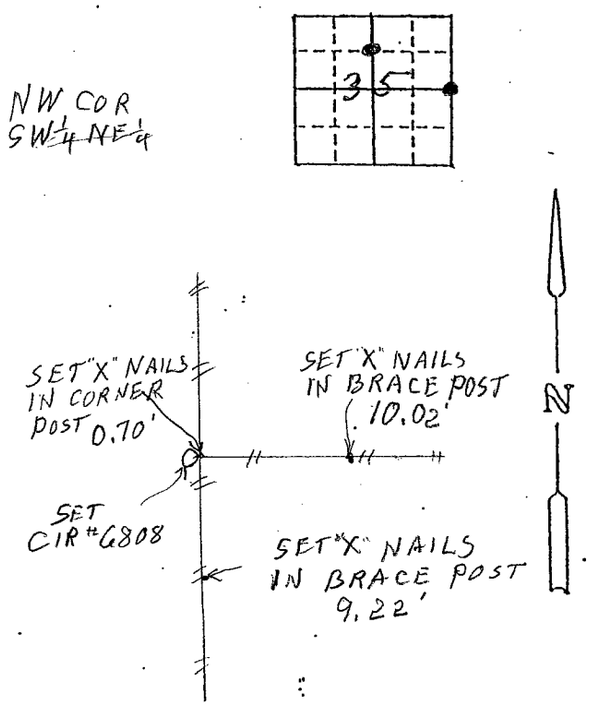

I hereby certify that this land surveying document was prepared and the related survey work was performed by me or under my direct personal supervision and that I am a duly licensed Land Surveyor under the laws of the State of Iowa.

J.M. Hochstetler

J.M. HOCHSTETLER
License number 6808 Date 8/21/09
My license renewal date is December 31, 2009
Pages or sheets covered by this seal: 1

LICENSED LAND SURVEYOR
J. M.
HOCHSTETLER
#6808
IOWA

List Corners to be Indexed

Corners	Section	Twp	Range
E ¼ COR	35	77N	26W
NW COR SW¼ NE¼	35	77N	26W