Document 2009 3467

Book 2009 Page 3467 Type 06 043 Pages 1
Date 11/16/2009 Time 3:04 PM
Rec Amt $9.00

INDX ✓
ANNO
SCAN

LISA SMITH, COUNTY RECORDER
MADISON COUNTY IOWA

CHEK

VANCE & HOCHSTETLER, P.C., CONSULTING ENGINEERS, WINTERSET, IOWA (515) 462-3995
CHARLES T. VANCE, 110 West Green St., Winterset, Iowa, 50273
JAMES M HOCHSTETLER, 110 West Green St., Winterset, Iowa 50273

09-1025

UNITED STATES PUBLIC LAND SURVEY CORNER CERTIFICATE

OF 5


Land Survey Monuments situated in Section 5, Township 77N, Range 28W, of the Fifth Principal Meridian, MADISON County, Iowa.
Previously recorded in _____ in County Recorder's Office.
(book, page, document number, etc.)


(Show reason for preparing this certificate, the evidence and detailed procedures used in establishing the the corner positions and monumentation found or placed.)


Monument Description and Remarks: NE COR - Set CIR # 6808 at 4-Way fence intersection of four different property owners
NW Cor NE¼ NE¼ - Set CIR # 6808 at midpoint on line between found N¼ Cor & Set NE Cor.
SW Cor SE¼ NE¼ - Set CIR #6808 at midpoint on line between found Center and E¼ Cor of Section

PLAN - VIEW

(Show a minimum of three reference ties to durable physical objects, relevant monuments and physical conditions that will enable recovery of the corner.)

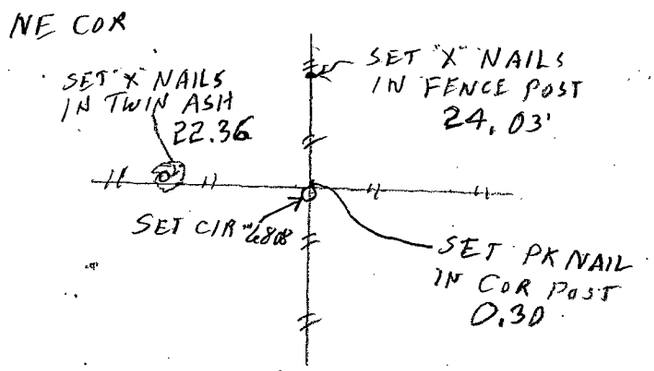

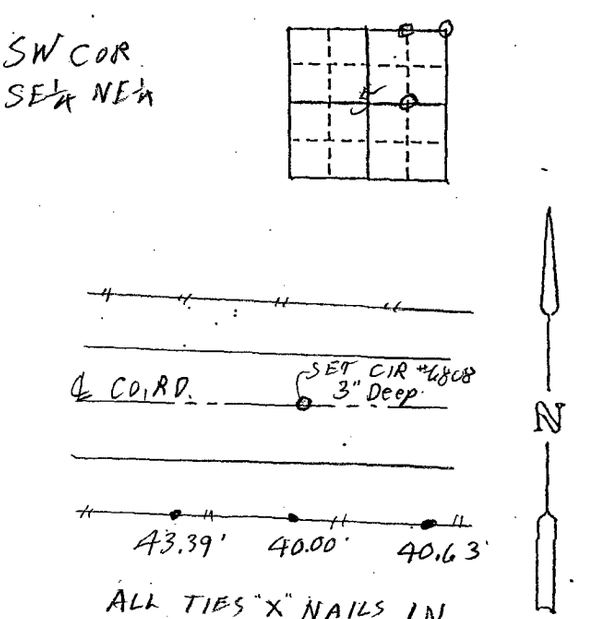

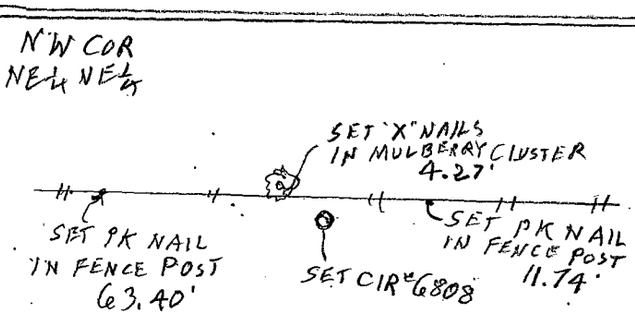

LICENSED LAND SURVEYOR
J. M. HOCHSTETLER
#6808
IOWA

I hereby certify that this land surveying document was prepared and the related survey work was performed by me or under my direct personal supervision and that I am a duly licensed Land Surveyor under the laws of the State of Iowa.

J.M. Hochstetler

J.M. HOCHSTETLER
License number 6808 Date 11/6/09
My license renewal date is December 31, 2009
Pages or sheets covered by this seal: 1

List Corners to be Indexed

Corners	Section	Twp.	Range
NE COR	5	77N	28W
NW COR NE¼ NE¼	5	77N	28W
SW COR SE¼ NE¼	5	77N	28W