Document 2009 3525

Book 2009 Page 3525 Type 06 043 Pages 1
Date 11/19/2009 Time 11:53 AM
Rec Amt $9.00

INDX ✓
ANNO
SCAN
CHEK

LISA SMITH, COUNTY RECORDER
MADISON COUNTY IOWA

VANCE & HOCHSTETLER, P.C., CONSULTING ENGINEERS, WINTERSET, IOWA (515) 462-3995
CHARLES T. VANCE, 110 West Green St., Winterset, Iowa, 50273
JAMES M HOCHSTETLER, 110 West Green St., Winterset, Iowa 50273

09-108s

UNITED STATES PUBLIC LAND SURVEY CORNER CERTIFICATE

OF


Land Survey Monuments situated in Section 13, Township 76 N, Range 29 W, of the Fifth Principal Meridian, MADISON County, Iowa.
Previously recorded in _____ in County Recorder's Office.
(book, page, document number, etc.)


(Show reason for preparing this certificate, the evidence and detailed procedures used in establishing the the corner positions and monumentation found or placed.)


Monument Description and Remarks: NW COR SW¼NE¼ - Set yellow CIR #6808 at mid point on line between Calculated Center and found N¼ Cor NW COR NE¼SW¼ - Set yellow CIR #6808 at midpoint on line between Calculated W¼ Cor (midpoint between NW Cor & SW Cor in line with existing fences) and calculated Center of Section (Intersect of found N¼, E¼, & S¼ Corss. & Calculated W¼ Cor) NW Cor. SW¼ SE¼ - Set yellow CIR #6808 at mid point between found S¼ COR and Calculated Center of Section.

PLAN - VIEW

(Show a minimum of three reference ties to durable physical objects, relevant monuments and physical conditions that will enable recovery of the corner.)

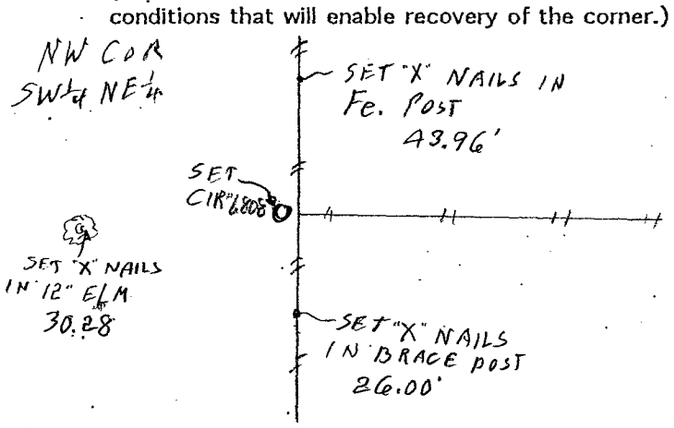

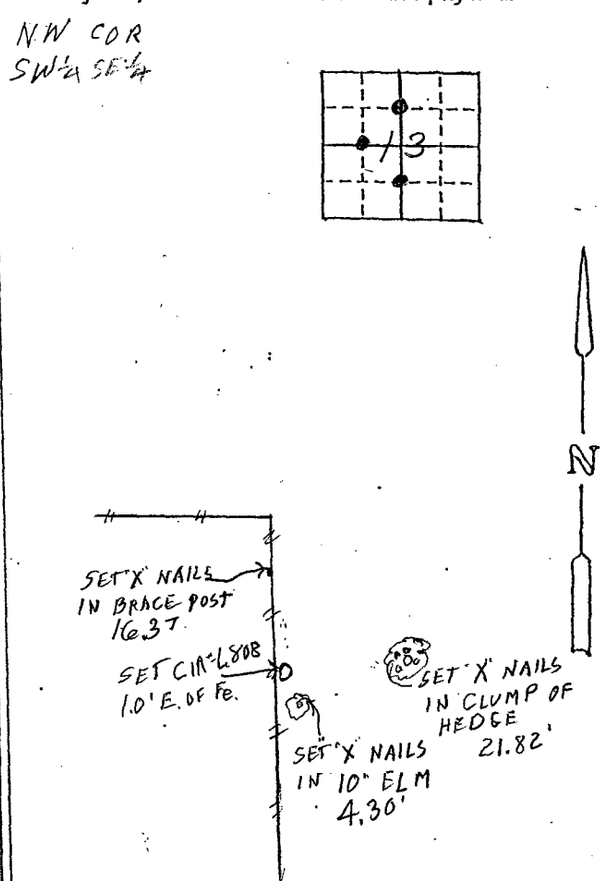

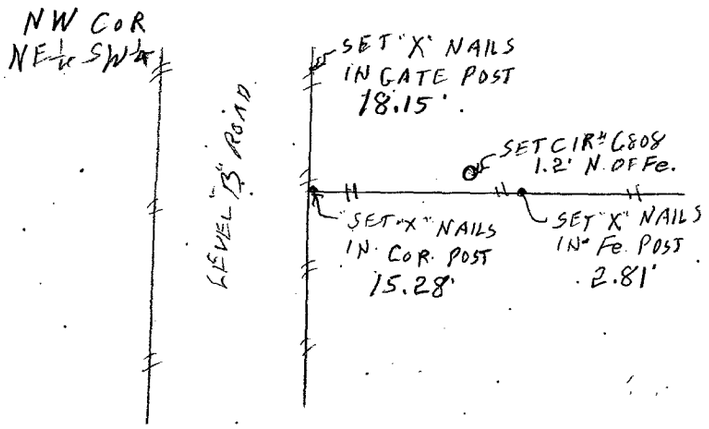

LICENSED LAND SURVEYOR
J. M.
HOCHSTETLER
#6808
IOWA

I hereby certify that this land surveying document was prepared and the related survey work was performed by me or under my direct personal supervision and that I am a duly licensed Land Surveyor under the laws of the State of Iowa.

J.M. Hochstetler

J.M. HOCHSTETLER
License number 6808 Date 11/12/09
My license renewal date is December 31, 2009
Pages or sheets covered by this seal: 1

List Corners to be Indexed

Corners	Section	Twp.	Range
NW COR SW¼ NE¼	13	76 N	29 W
NW COR NE¼ SW¼	13	76 N	29 W
NW COR SW¼ SE¼	13	76N	29W