Document 2008 32
Book 2008 Page 32 Type 06 043 Pages 1
Date 1/04/2008 Time 10:35 AM
Rec Amt $7.00
INDX ✓
ANNO
SCAN
LISA SMITH. COUNTY RECORDER
MADISON IOWA
CHEK

HACKETT SURVEYING, Prepared By: Michael James Hackett, 712 North 9th. Ave., Winterset, Ia. 50273, Tel. (515) 462-1106

UNITED STATES PUBLIC LAND SURVEY CORNER CERTIFICATE OF


Land Survey Monuments situated in Section 29, Township 77 N, Range 26 W, of the Fifth Principal Meridian, Madison County, Iowa.
Previously recorded in _____ in County Recorder's Office.
(book, page, document number, etc.)

(Show reason for preparing this certificate, the evidence and detailed procedures used in establishing the corner positions and monumentation found or placed.)

Monument Description and Remarks: Searched and probed for corner with nothing found. Set 5/8" x 18" rebar with red plastic cap, PLS #14672. The position of the corner is based on calculating the mid point between the found northeast corner of the Northeast Quarter of the Southwest Quarter and the southeast corner of the Southeast Quarter of the Southwest Quarter. An 1892 road record in Book 3, Page 10, on file in the Madison County Engineers references the corner in the centerline description of the old roadway. The 1892 road record centerline is referenced as being 20 foot south and 20 foot east of the corner. The field evidence of the old road bed verifies the calculated position of the corner. Also traversed to the southeast corner of the Northeast Quarter of the Southeast Quarter to verify corner position.

PLAN VIEW

(Show a minimum of three reference ties to durable physical objects, relevant monuments and physical conditions that will enable recovery of the corner.)

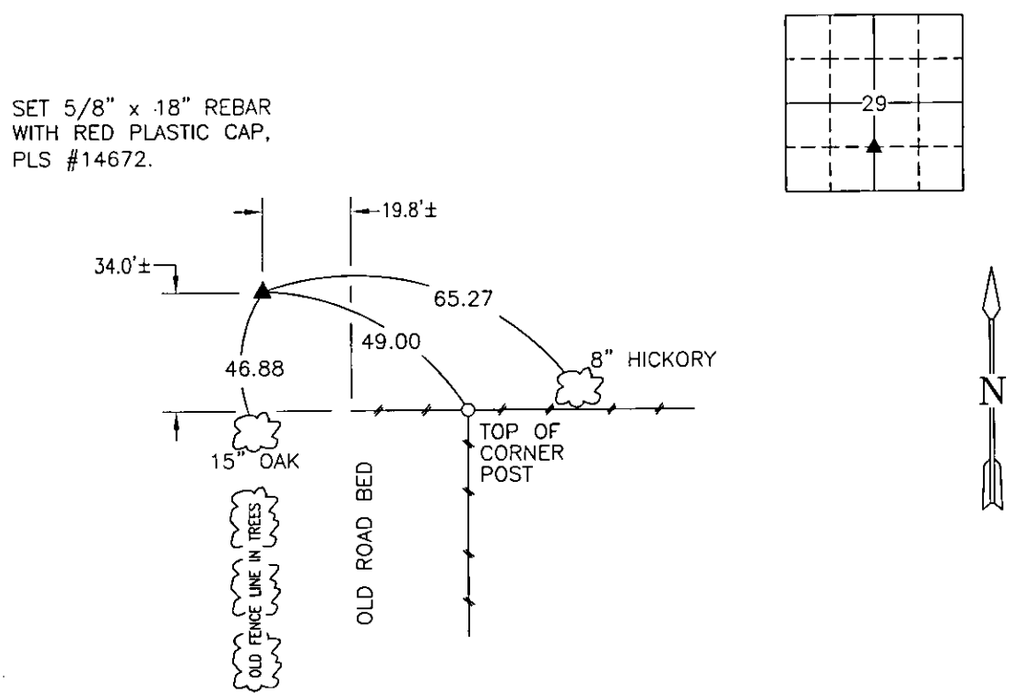

SE. COR., NE. 1/4, SW. 1/4, SEC. 29

NOTE: ALL TIES TO "X" NAILS UNLESS NOTED

LICENSED PROFESSIONAL ENGINEER & LAND SURVEYOR
MICHAEL JAMES HACKETT 14672
IOWA

I hereby certify that this land surveying document was prepared and the related survey work was performed by me or under my direct personal supervision and that I am a duly Licensed Land Surveyor under the laws of the State of Iowa.

Signed _____ Date 1-4-2008
Michael James Hackett

Iowa license number 14672.
My license renewal date is 12/31/2008.
Pages covered by this seal: 1.

33-07-01